LAND CORNER RECORDATION CERTIFICATE

Filing Requirement of Act 74, Mich. P.A. 1970

#167

For corners in Mackinac (County)

	Located In:	Corner Code #
1. Public Land Survey	T 43N R 7W	612
	T ___ R ___	
	T ___ R ___	
	T ___ R ___	
2. Property Controlling	S ___ T ___ R ___	
in Section	S ___ T ___ R ___	
3. Miscellaneous	S ___ T ___ R ___	
Property in Sec.	S ___ T ___ R ___	

10048

Register of Deeds Stamp & File Number

4. Lot No. _____ , Recorded Plat _____
5. Private Claims _____

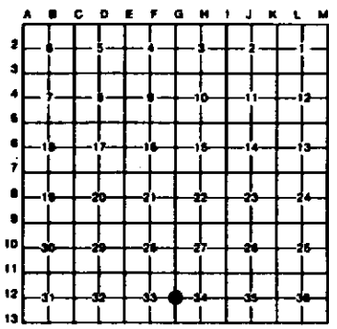

I, Stephan J. Szyszkoski , in a field survey on June 06, 1991 , 19 _____ , do hereby certify that under requirements of P.A. 74, Michigan P.A. of 1970, the corner points mentioned in lines 1 and 2 above were in conformance with regulations and rules therefore as required in the current manual of survey instructions of the United States Department of the Interior, Bureau of Land Management or by a decree of a Court of Law and/or that the corner points mentioned in lines 3, 4 and 5 above were in conformance with the rules of the Michigan Board of Land Surveyors or by a Decree of a Court of Law; established, re-established, monumented, re-monumented, recovered, found as expressed below:

NOTE: Not more than 4 corners, all in the same town and range, may be recorded on this certificate.

A. Description of original monument and accessories and/or subsequent restoration:

(612) Corner previously recorded by Billy D. Buckler as a 1" pipe with 4" aluminum cap placed in 1963 with accessories as follows: 10" Jack Pine N51W 32 links, 8" R. Pine N48E 35.5 links.

B. Description of corner evidence found and/or method applied in restoring or reestablishing corner:

(612) Found and accepted 1" pipe with 4" aluminum cap placed by Buckler with his record witness trees agreeing. Rescribed BH blaze on Buckler's trees and marked two additional witness trees.

C. Description of monument for corner and accessories established to perpetuate locating the position of the corner:

(612) 1" pipe with 4" aluminum tablet. 10" J. Pine S50E 12.6'; 8" J. Pine S55W 12.2'; 12" J. Pine N51W 21.1'; 12" R. Pine N48E 23.4'. Blazed and scribed new witness trees at base and BH. Distances are to face of base blaze.

STATE OF MICHIGAN
STEPHAN J. SZYSZKOSKI
LAND SURVEYOR
No. 33986
LICENSED LAND SURVEYOR

Signed by Stephan J. Szyszkoski Date 3-16-92

Surveyor's Michigan License No. 33986

FORM APPROVED BY MICHIGAN STATE BOARD OF LAND SURVEYORS, JAN. 28, 1971
REVISED MAY 14, 1979
REVISED JAN., 1983