

LAND CORNER RECORDATION CERTIFICATE
Filing Requirement of Act 74, Mich. P.A. 1970

For corners in
Mackinac

(County)

Located In:

Corner Code #

1. Public Land Survey	T <u>43N</u> R <u>7W</u>	<u>K8</u>
	T <u> </u> R <u> </u>	<u> </u>
	T <u> </u> R <u> </u>	<u> </u>
	T <u> </u> R <u> </u>	<u> </u>
2. Property Controlling in Section	S <u> </u> T <u> </u> R <u> </u>	<u> </u>
	S <u> </u> T <u> </u> R <u> </u>	<u> </u>
3. Miscellaneous Property in Sec.	S <u> </u> T <u> </u> R <u> </u>	<u> </u>
	S <u> </u> T <u> </u> R <u> </u>	<u> </u>

Register of Deeds Stamp & File Number

4. Lot No. _____, Recorded Plat _____
 5. Private Claims _____

Mar 23 2004

I, Stephan J. Szyszkoski, in a field survey on _____, 19____ do hereby state that under requirements of P.A. 74, Michigan P.A. of 1970, the corner points mentioned in lines 1 and 2 above were in conformance with regulations and rules therefore as required in the current manual of survey instructions of the United States Department of the Interior, Bureau of Land Management or by a decree of a Court of Law and /or that the corner points mentioned in lines 3, 4 and 5 above were in conformance with the rules of the Michigan Board of Land Surveyors or by a Decree of a Court of Law; established, re-established, monumented, recovered, found as expressed below:

NOTE: Not more than 2 corners, all in the same town and range, may be recorded on this certificate.

A	B	C	D	E	F	G	H	I	J	K	L	M
1												
2	6		5		4		3		2		1	
3												
4	7		8		9		10		11		12	
5												
6	18		17		16		15		14		13	
7												
8	19		20		21		22		23	●	24	
9												
10	30		29		28		27		26		25	
11												
12	31		32		33		34		35		36	
13												


A. Description of original monument and accessories and/or subsequent restoration:
 (K8) Quarter corner common to Sections 23-24. Reestablished in 1966 by F.J. Bray, RLS, midway between Section corners. Set 1" iron pipe with 4" aluminum cap. 8" Cedar South 07 links, 9" Hemlock N73W 22 links.

B. Description of corner evidence found and/or method applied in restoring or reestablishing corner:

(K8) Recovered the 1966 monument in good condition and at record bearing and distance from the 1966 witnesses. The Hemlock is in good condition, the Cedar is standing dead. I used this monument to control a subdivision of Section 23 this date.

C. Description of monument for corner and accessories established to perpetuate locating the position of the corner:

(K8) Found 1" ID I. pipe with 4" alum. MDNR cap. Blazed, scribed, and set measuring nails in:
 7" Maple N88E 14.4' "1/4S NBT"
 10" Maple S40E 14.9' do
 5" Cedar S31W 11.8' do
 the 1966 witness:
 12" Hemlock N70W 14.95' "1/4S"
 Bearings are magnetic. Distances are to nail with tag.

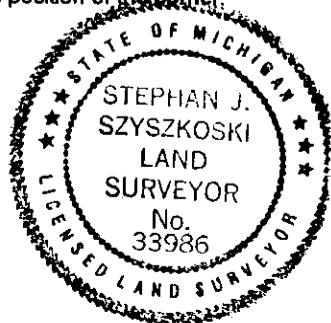

Signed by Stephan J. Szyszkoski
 Surveyor's Michigan License No. 33986

Date 4/6/04