

**LAND CORNER RECORDATION CERTIFICATE**  
**Filing Requirement of Act 74, Mich. P.A. 1970**

For corners in  
Mackinac

(County)

Located In:

Corner Code #

1. Public Land Survey	T	43N	R	7W	K7
	T		R		
	T		R		
	T		R		
2. Property Controlling in Section	S	23	T	43N R 7W	2
	S		T	R	
3. Miscellaneous Property in Sec.	S		T	R	
	S		T	R	

Register of Deeds Stamp & File Number

4. Lot No. \_\_\_\_\_, Recorded Plat \_\_\_\_\_  
 5. Private Claims \_\_\_\_\_

Mar 23 2004

I, Stephan J. Szyszkoski, in a field survey on \_\_\_\_\_, 19\_\_\_\_ do hereby state that under requirements of P.A. 74, Michigan P.A. of 1970, the corner points mentioned in lines 1 and 2 above were in conformance with regulations and rules therefore as required in the current manual of survey instructions of the United States Department of the Interior, Bureau of Land Management or by a decree of a Court of Law and /or that the corner points mentioned in lines 3, 4 and 5 above were in conformance with the rules of the Michigan Board of Land Surveyors or by a Decree of a Court of Law; established, re-established, monumented, recovered, found as expressed below:


NOTE: Not more than 2 corners, all in the same town and range, may be recorded on this certificate.

A	B	C	D	E	F	G	H	I	J	K	L	M
1												
2	6		5		4		3		2		1	
3												
4	7		8		9		10		11		12	
5												
6	18		17		16		15		14		13	
7												
8	19		20		21		22		23		24	
9												
10	30		29		28		27		26		25	
11												
12	31		32		33		34		35		36	
13												

A. Description of original monument and accessories and/or subsequent restoration:  
 (K7) Section corner common to 13-14-23-24. Remonumented in 1962 by Billy D. Buckler at Marcus Schaaf position and in accord with original B.T. Set 1"ID iron pipe with 4" brass cap. 5" Cedar N25W 17 links, 12" Cedar N34E 40 links.  
 (2-Sec. 23) East 1/16 corner between Sections 14 and 23. Established in 1966 by F.J.Bray RLS midway between 1/4 and Section corners. Set 1"ID iron pipe with 4" aluminum cap. 8" Cedar S60E 06 links, 8" Cedar S11W 23 links.

B. Description of corner evidence found and/or method applied in restoring or reestablishing corner:  
 (K7) Found the 1962 monument in good condition and at record bearing and distance from the 1962 NBTs, now both down. I used this monument to control a subdivision of Sec. 23 this date.  
 (2-Sec. 23) Recovered the 1966 monument disturbed, laid over in the muck. Reestablished the corner position at record bearing and distance from the 1966 BTs, both in good condition with measuring notches visible. Reinstalled the 1966 monument at the record position. Measurements to government corners east and west check quite well with the record.

C. Description of monument for corner and accessories established to perpetuate locating the position of the corner:  
 (K7) Found 1"ID iron pipe with 4" brass MDNR cap. Blazed, scribed, and set measuring nails in:  
 4" Cedar N41W 4.8' "S14 NBT"  
 12" Cedar N19W 36.65' "S14 NBT"  
 4" Cedar N87E 11.75' "S13 NBT"  
 3" Cedar N87W 8.25' "S14 NBT"  
 Bearings are magnetic. Distances are to nail with tag.  
 (2) Set 1"IDx36" I.pipe with 4" alum. MDNR cap (1966 DNR mon). Blazed, scribed, and set measuring nails in:  
 7" Cedar N14W 22.05' "E1/16 BT"  
 7" Cedar N71W 13.25' do  
 The 1966 wits:  
 10" Cedar S55E 4.1' "E1/16"  
 11" Cedar S16W 15.6' do  
 Bearings are magnetic. Distances are to nail with tag.

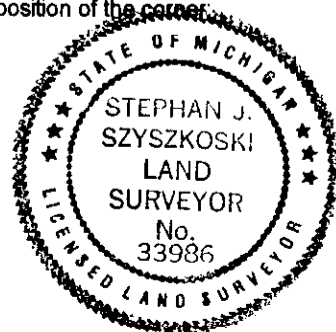

Signed by Stephan J. Szyszkoski  
 Surveyor's Michigan License No. 33986

Date 4/6/04