

LAND CORNER RECORDATION CERTIFICATE
Filing Requirement of Act 74, Mich. P.A. 1970

For corners in Mackinac <hr/> (County)	Located In:	Corner Code #
1. Public Land Survey	T ___ R ___	_____
	T ___ R ___	_____
	T ___ R ___	_____
	T ___ R ___	_____
2. Property Controlling in Section	S <u>23</u> T <u>43N</u> R <u>7W</u>	<u>9</u>
	S <u>23</u> T <u>43N</u> R <u>7W</u>	<u>6</u>
3. Miscellaneous Property in Sec.	S ___ T ___ R ___	_____
	S ___ T ___ R ___	_____

Register of Deeds Stamp & File Number

4. Lot No. _____, Recorded Plat _____
 5. Private Claims _____

Mar 15 2004

I, Stephan J. Szyszkoski, in a field survey on _____, 19 ____ do hereby state that under requirements of P.A. 74, Michigan P.A. of 1970, the corner points mentioned in lines 1 and 2 above were in conformance with regulations and rules therefore as required in the current manual of survey instructions of the United States Department of the Interior, Bureau of Land Management or by a decree of a Court of Law and /or that the corner points mentioned in lines 3, 4 and 5 above were in conformance with the rules of the Michigan Board of Land Surveyors or by a Decree of a Court of Law; established, re-established, monumented, recovered, found as expressed below:

NOTE: Not more than 2 corners, all in the same town and range, may be recorded on this certificate.


A	B	C	D	E	F	G	H	I	J	K	L	M
1												
2	6		5		4		3		2		1	
3												
4	7		8		9		10		11		12	
5												
6	18		17		16		15		14		13	
7												
8	19		20		21		22		23		24	
9												
10	30		29		28		27		26		25	
11												
12	31		32		33		34		35		36	
13												

A. Description of original monument and accessories and/or subsequent restoration:
 (9-Sec. 23) East 1/16 corner Section 23. Not established in the original survey.
 (6-Sec. 23) Northeast 1/16 corner, Section 23. Not established in the original survey.

B. Description of corner evidence found and/or method applied in restoring or reestablishing corner:
 (9-Sec. 23) Established the corner midway and on a straight line between 1/4 corner 1315.93' east and Center of Section 1315.93' west.
 (6-Sec. 23) Established the corner at the intersection of straight lines connecting opposite 1/16 corners. The corner falls in a open marsh and there are no nearby trees to mark for witnesses.

C. Description of monument for corner and accessories established to perpetuate locating the position of the corner:

(9) Set 1"IDx36" I.pipe with 4" alum. MDNR cap. Blazed, scribed, and set measuring nails in: 5" Cedar S37W 6.2' "E1/16 BT" 6" Cedar N86W 10.4' do 4" Cedar S01W 8.0' do 11" Cedar N38E 30.7' do Bearings are magnetic. Distances are to nail with tag.	(6) Set 1"IDx36" I.pipe with 4" alum. MDNR cap. Blazed, scribed, and set measuring nails in: 4" Birch S86E 266.75' "NE1/16 BT" 7" Cedar S30E 393.47' do 15" Birch S01E 415.91' do 6" Birch N67E 217.28' do Bearings are magnetic. Distances are to nail with tag and were measured with an EDM1.
---	---

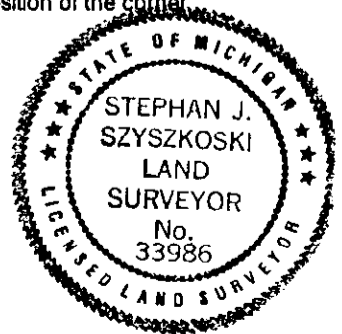

Signed by Stephan J. Szyszkoski Date 4/06/04
 Surveyor's Michigan License No. 33986