LAND CORNER RECORDATION CERTIFICATE
Filing Requirement of Act 74, Mich. P.A. 1970 as Amended

For corners in

Mackinac (County)

	Located In:	Corner Code #
1. Public Land Survey	T 43N R 7W	E1
	T___ R___	
	T___ R___	
	S___ T___ R___	
2. Property Controlling	S___ T___ R___	
in Section	S___ T___ R___	
3. Miscellaneous	S___ T___ R___	
Property in Sec.	S___ T___ R___	

Register of Deeds Stamp & File Number

4. Lot No. _____ , Recorded Plat_____

5. Private Claims

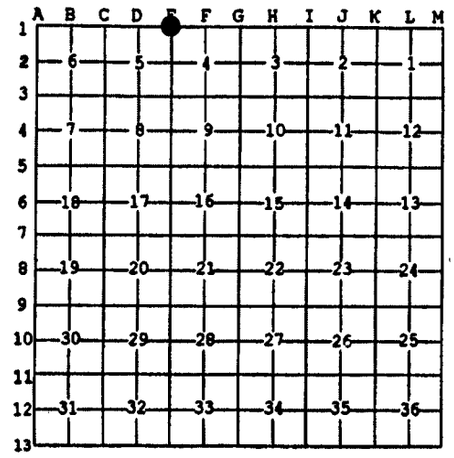

Aug 15 2005

I, Stephan J. Szyszkoski, in a field survey on _____, 20 ____ do hereby state that under requirements of P.A. 74, Michigan P.A. of 1970, the corner points mentioned in lines 1 and 2 above were in conformance with regulations and rules therefore as required in the current manual of survey instructions of the United States Department of the Interior, Bureau of Land Management or by a decree of a Court of Law and /or that the corner points mentioned in lines 3, 4 and 5 above were in conformance with the rules of the Michigan Board of Land Surveyors or by a Decree of a Court of Law; established, re-established, monumented, recovered, found as expressed below:

NOTE: Not more than 2 corners, all in the same town and range, may be recorded on this certificate.

A. Description of original monument and accessories and/or subsequent restoration:

(E1) Closing corner common to Sections 4-5. 1961 - Remonumented by Billy D. Buckler RLS at the original position as perpetuated by Marcus Schaaf RLS. Two Tamarack B.Ts bearing S47E 17 links and S6W 14 links...still in place in fair condition. Mr. Buckler notes that this closing corner lies 16 links West of the Section corner for 32 and 33 T44N-R07W. Set 1" pipe with 4" brass cap. Witnesses to corner: 5" Cedar S57W 19 links.

B. Description of corner evidence found and/or method applied in restoring or reestablishing corner:

(E1) Found the 1961 monument in good condition and at record bearing and distance from the 1961 witness Cedar in good condition with open blazes. The stumps of the original Tamarack B.T.s are intact and at record bearing and distance. Accepted the monument as a careful and faithful perpetuation of the position of the original corner.

C. Description of monument for corner and accessories established to perpetuate locating the position of the corner:

(E1) Found 1"ID I.pipe with 4" brass
Mich. Dept. of Conservation cap. Set
measuring nails in:
6" Cedar S64W 12.75' old blazes *
6" Cedar N18W 5.3' mrkd "S32 NBT"
4" Cedar N24E 9.65' do
6" Cedar N82W 25.4' do
Bearings are magnetic. Distances are to
nail with tag. * denotes 1961 NBT.

STATE OF MICHIGAN
STEPHAN J. SZYSZKOSKI
LAND SURVEYOR
No. 33986
LICENSED LAND SURVEYOR

Signed by Stephan J. Szyszkoski Date 1/26/06

Surveyor's Michigan License No. 33986

For the Michigan Department of Natural Resources, Office of Land and Facilities

FORM APPROVED BY MICHIGAN STATE BOARD OF PROFESSIONAL SURVEYORS, JAN. 28, 1971
Revised May 14, 1975
Revised Jan., 1983
Revised Oct., 1995