



SKETCH OF
 FRACTIONAL
 SEC. 29, T43N R8W.
 MACKINAC CO.

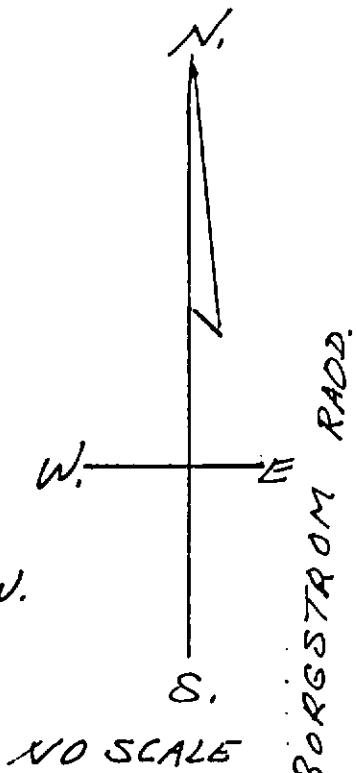

NO SCALE

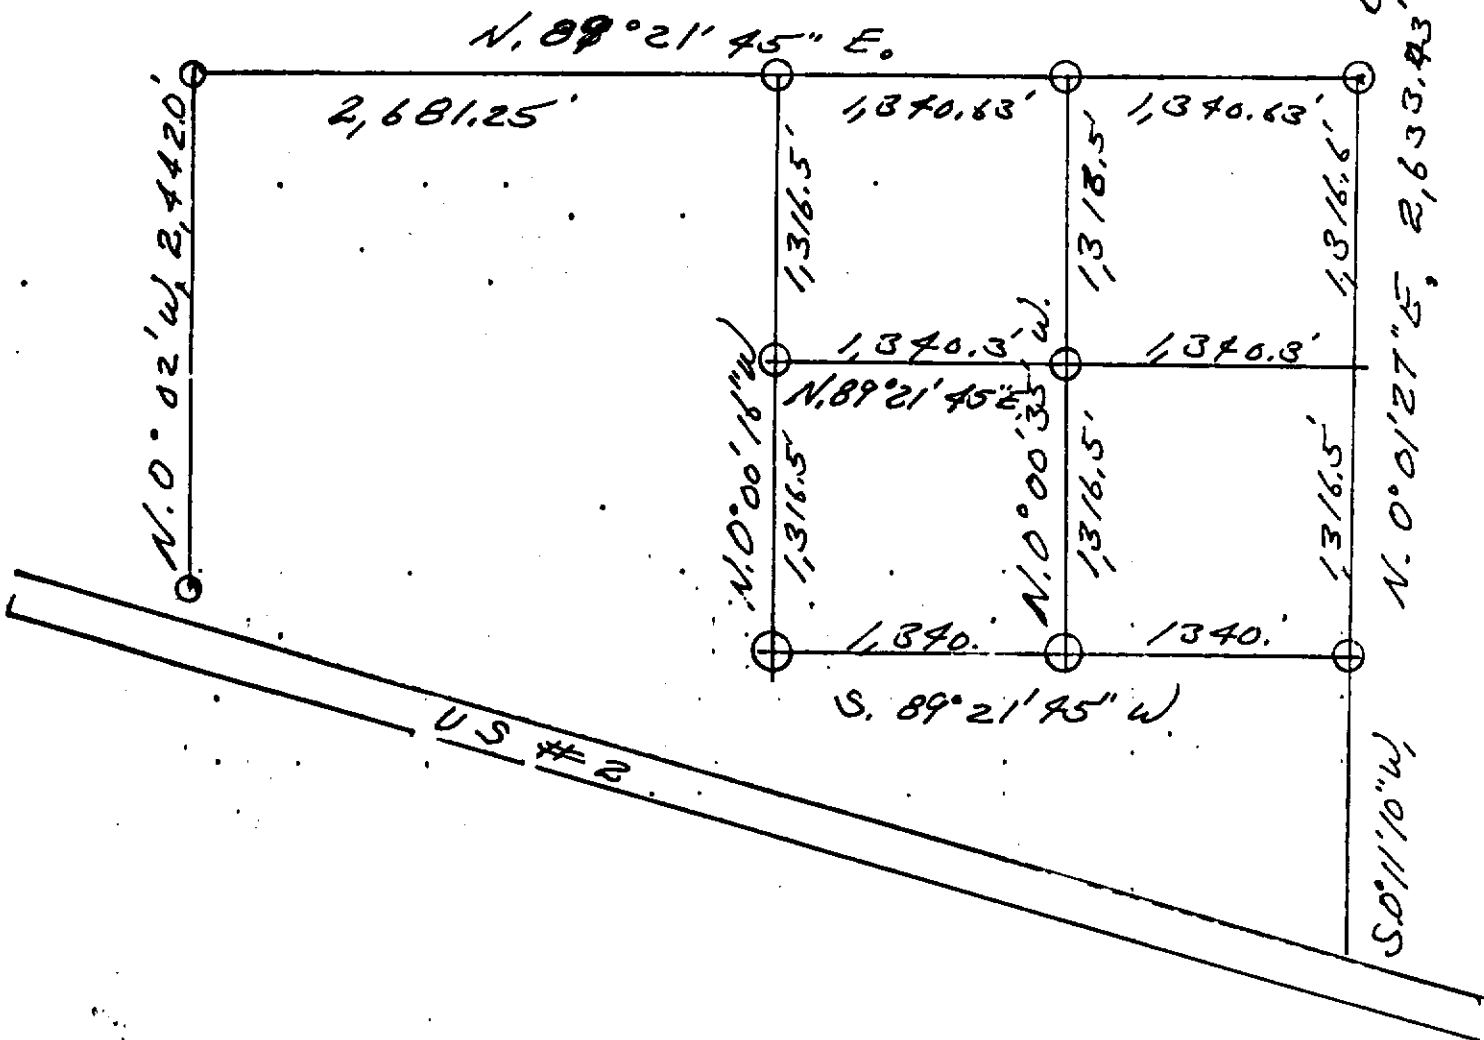

9-12-78

Billy D. Buckler
 REG. LAND SURVEYOR
 # 0001