


SKETCH OF  
 SEC. 4, T43N R8W  
 MACKINAC CO.

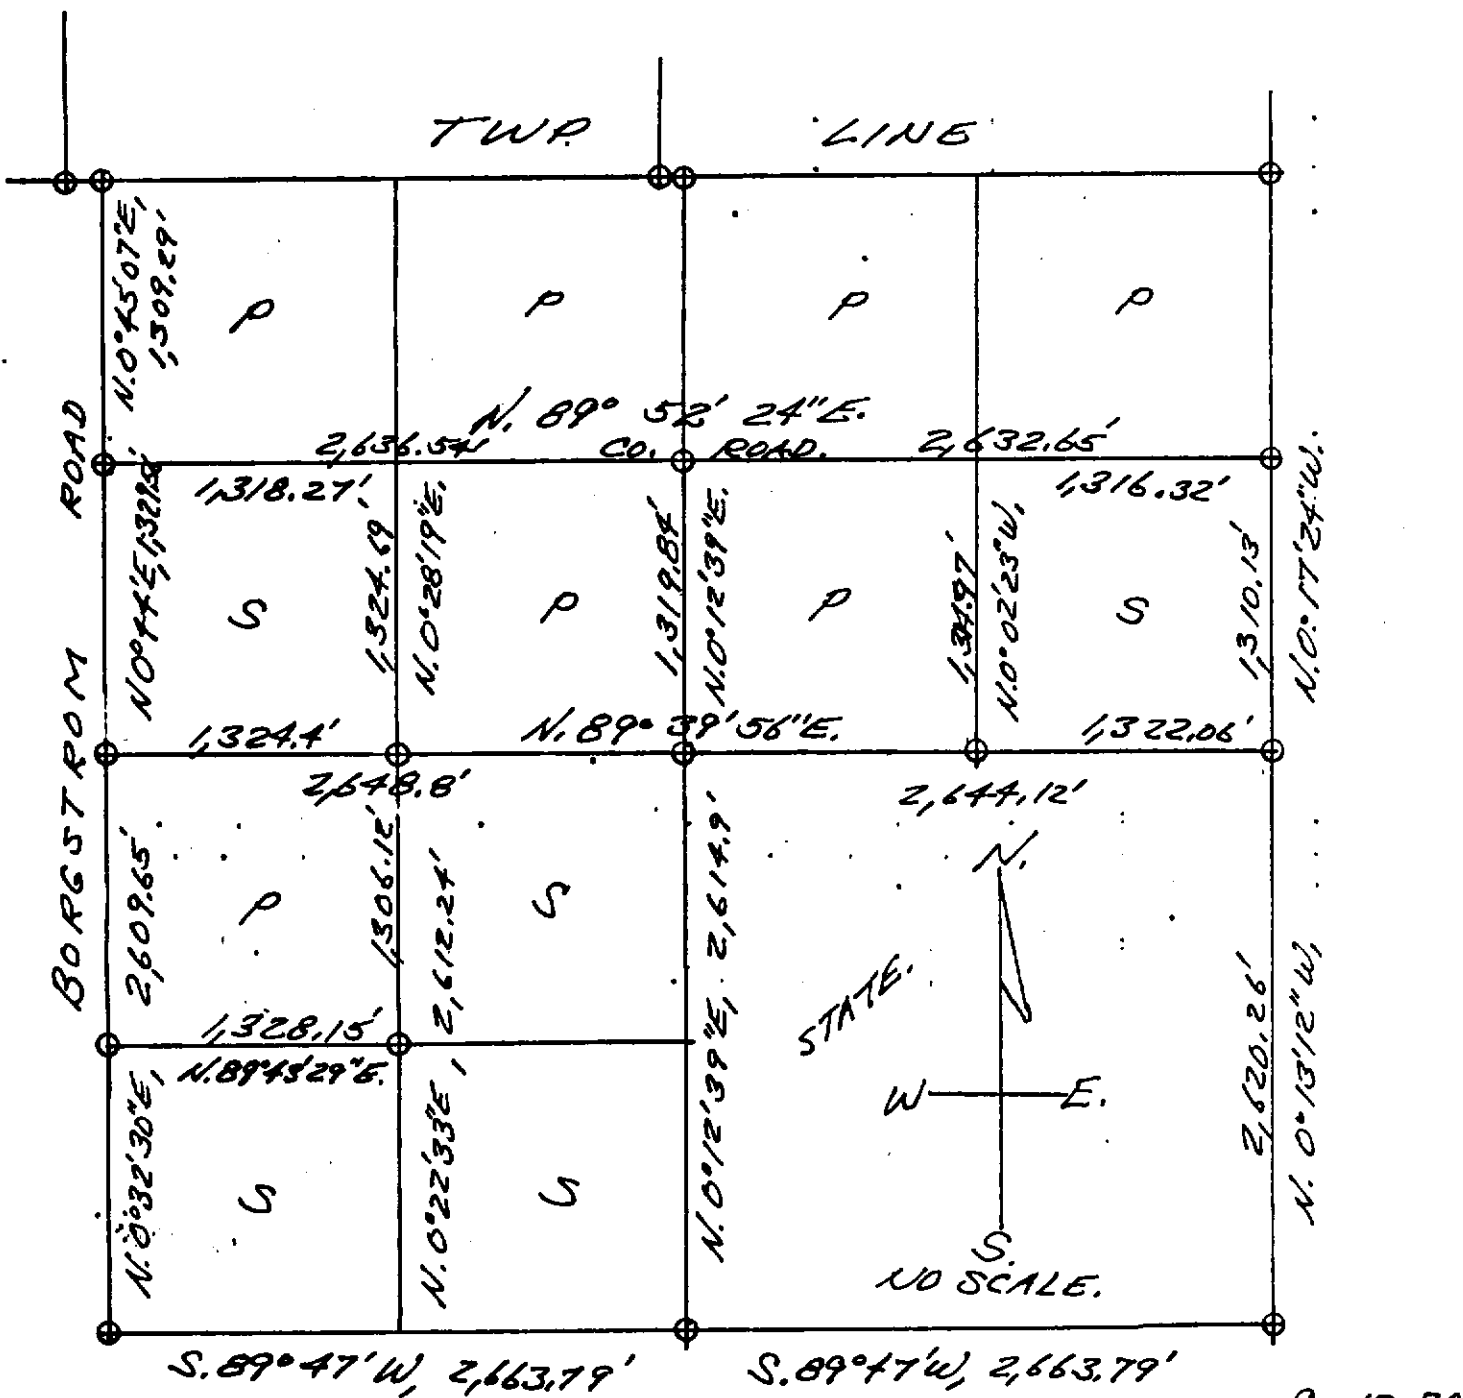

9-12-78

BILLY D. BUCKLER  
 REG. LAND SURVEYOR  
 # 8007