

MICHIGAN
DEPARTMENT OF CONSERVATION
FORESTRY DIVISION

LAND CORNER RECORD

T. 43 N.R. 8W


Macackinac COUNTY

DESCRIPTION OF CORNER Section Corner common to Sections 4-5-8-9

CORNER MONUMENT 1 1/4" x 30" pipe driven in center of road.

DATE MONUMENT PLACED AND WITNESSED 5/22/68

WITNESSES TO CORNER..... 6" Cedar (S8 NBT) S87°W 53.1'

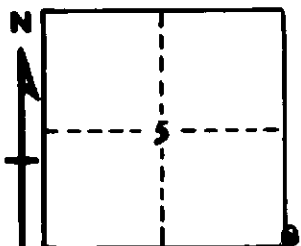

7" Cedar (S5 NBT) N50°W 73.2'

AND

CIRCLE CORNER REGISTERED

DESCRIPTION IN DETAIL AS TO HOW CORNER WAS LOCATED AND IDENTIFIED OR RESTORED.

This corner re-established by single proportionate measure to North and South, and on the alignment of a North and South Road.

SURVEYOR'S SEAL

SIGNED *Billy D. Buckler*
Billy D. Buckler R.L.S. DATE 9/25/68
REGISTERED LAND SURVEYOR