

MICHIGAN
DEPARTMENT OF CONSERVATION
FORESTRY DIVISION

LAND CORNER RECORD

T. 43 N.R. 8W


Mackinac COUNTY

DESCRIPTION OF CORNER Section Corner common to Sections 26-27-34-35

CORNER MONUMENT 1 1/4" x 30" Iron pipe, buried in LC of North-South Road.

DATE MONUMENT PLACED AND WITNESSED 4/30/68

WITNESSES TO CORNER..... 9" Cedar (S26 NBT) N75°E 24.6'

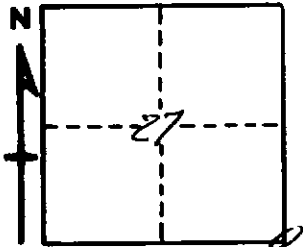

6" Cedar (35 NBT) S50°E 25.0'

AND

DESCRIPTION IN DETAIL AS TO HOW CORNER WAS LOCATED AND IDENTIFIED OR RESTORED.

Placed location poster 10' West of Corner.

This corner re-established in N.-S. road and by proportionate measure between corners; one mile North and 1/2 mile South.

SURVEYOR'S SEAL

SIGNED Billy D. Buckler
Billy D. Buckler R.L.S. DATE 9/25/68
REGISTERED LAND SURVEYOR