

FILING REQUIREMENT OF ACT 74, MICH. P.A.1970

MACKINAC CO.

3 CORNERS

FOR CORNERS OF--:	LOCATED IN--:	CORNER CODE NUMBER
1. PUBLIC LAND SURVEY_____	T. <u>43</u> N. <u>8</u> E. <u>W.</u>	<u>C-2, B-2, B-1</u>
2. PROPERTY CONTROLLING IN SECTION_____	, T. _____ N. _____ E. _____ S. _____ R. _____ W. _____	_____
3. MISCELLANEOUS PROPERTY IN SECTION_____	, T. _____ N. _____ E. _____ S. _____ R. _____ W. _____	_____
4. LOT NO. _____, RECORDED PLAT _____		
5. PRIVATE CLAIMS _____		

REGISTER OF DEEDS STAMP AND
FILING NUMBER

I, Gerald L. Wiggins, do hereby certify that under requirements of P.A. 74, Michigan P.A. of 1970, the corner points mentioned in lines 1 and 2 above were, in a field survey on 7-3, & 6-30, 19 86, established, re-established, monumented, re-monumented, recovered or restored as expressed below and in conformance with regulations and rules therefore as required in the current manual of survey instructions of the United States Department of the Interior, Bureau of Land Management or by a decree of a court of law. Furthermore, that the corner points mentioned in lines 3, 4 and 5 above were, in a field survey on _____, 19____, found, recovered, restored, established or re-established as expressed below and in conformance with the rules of the Michigan State Board of Registration for Land Surveyors or, by a Decree of a Court of law:

A. Description of original monument and accessories and/or subsequent restoration:

- C-2 East 1/4 Cor. of Section 6. OBT'S: Beech 6, N9°W, 21 lks. & Beech 6, S57°W, 32 lks.
 B-2 Center of Section 6. Not prev. set.
 B-1 North 1/4 Cor. of Section 6. OBT'S: Hemlock 15, N71°E, 25 lks. & Hemlock 15, N30°W, 21 lks

B. Description of corner evidence found and/or method applied in restoring or re-establishing corner:


- C-2 Corner set at intersection of old fence lines north, east, and west.
 B-2 Corner set at intersection of N-S and E-W 1/4 line by closed traverse.
 B-1 Corner set by single proportionate measure between NW and NE Section Corners of Section 6.

C. Description of monument for corner and accessories established to perpetuate locating the position of the corner DNR except B-

- | | | | |
|-----|--|-----|-------------------------------|
| C-2 | 12" Twin Maples, S65°E, 26.7' | B-1 | Dist. are slope. |
| | 10" Maple, S9°E, 30.8' | | 8" Twin W. Birch, S8°E, 61.5' |
| | 12" Maple, N88°W, 39.9' | | 4" Maple, S15°E, 73.7' |
| | 14" Cherry, N5°E, 20.1' | | 10" W. Birch, S17°W, 56.8' |
| | Cor. set in fence lines N-E-W. | | 6" W. Birch, S47°W, 77.7' |
| B-2 | 1" Pipe w/plastic RLS Cap buried in center N-S Road. | | Cor. lies 13½' North of R.R. |
| | 14" Twin Cherry, N44°E, 32.8' | | |
| | 12" Twin Cherry, S38°W, 46.85' | | |
| | 10" Twin Maple, S84°W, 31.2' | | |
| | 6" Maple, N57°W, 26.6' | | |

SIGNED BY Gerald L. Wiggins
 Gerald L. Wiggins
 SURVEYOR'S MICHIGAN REGISTRATION NO. 23521

DATE 9-22-86

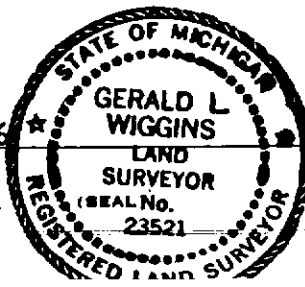

FOR STATE AND UNITED STATES AGENCIES: