

LAND CORNER RECORDATION CERTIFICATE
Filing Requirement of Act 74, Mich. P.A. 1970 as Amended

For corners in

<u>Mackinac</u> (County)	Located In:	Corner Code #
1. Public Land Survey	T <u>43N</u> R <u>8W</u>	<u>F3</u>
	T <u>43N</u> R <u>8W</u>	<u>E3</u>
	T _____ R _____	_____
2. Property Controlling in Section	S _____ T _____ R _____	_____
	S _____ T _____ R _____	_____
3. Miscellaneous Property in Sec.	S _____ T _____ R _____	_____
	S _____ T _____ R _____	_____

Register of Deeds Stamp & File Number

4. Lot No. _____, Recorded Plat _____

5. Private Claims
 E3 Apr 26 2007
 F3 Apr 24 2007

I, Stephan J. Szyszkoski, in a field survey on _____, 20____ do hereby state that under requirements of P.A. 74, Michigan P.A. of 1970, the corner points mentioned in lines 1 and 2 above were in conformance with regulations and rules therefore as required in the current manual of survey instructions of the United States Department of the Interior, Bureau of Land Management or by a decree of a Court of Law and /or that the corner points mentioned in lines 3, 4 and 5 above were in conformance with the rules of the Michigan Board of Land Surveyors or by a Decree of a Court of Law; established, re-established, monumented, recovered, found as expressed below:

NOTE: Not more than 2 corners, all in the same town and range, may be recorded on this certificate.

A. Description of original monument and accessories and/or subsequent restoration:


(F3) Quarter corner common to Sections 4-9. 1974 - Reestablished by Billy D. Buckler RLS midway and on line between Section corners. Set 1" pipe with 4" aluminum cap. 8" W.Birch S30E 18.6', 6" twin B.Spruce N24E 13.9'.
 (E3) Corner common to Sections 4-5-8-9. 1968 - Reestablished by Billy D. Buckler RLS by single proportionate measurement to North and South, and on the alignment of a North and South road. Set 1.25" x 30" pipe driven in center of road. 6" Cedar S87W 53.1', 7" Cedar N50W 73.2'. 1978 - note in MDNR corner files at Newberry office state: " Placed 36" T-iron 5-17-78 as cor. pipe had been removed. BDB".

B. Description of corner evidence found and/or method applied in restoring or reestablishing corner:

(F3) Recovered the 1974 monument in good condition and at record bearing and distance from the remains of the 1974 NBTs, now both stumps. The position of the monument is 0.8' NW of the midway position intended in 1974. I accept the monument as a careful and faithful reestablishment of the position of the original corner.
 (E3) Found a spike driven into the road surface at record bearing and distance from the 1968 bearing trees, both found in good condition. The position of the spike checks proportionately with Section corners 1 mile north and south. Accepted the spike as the 1968 position and as a careful and faithful reestablishment of the position of the original corner.

C. Description of monument for corner and accessories established to perpetuate locating the position of the corner:

(F3) Found 1" ID I.pipe with 4" alum. MDNR cap. Set measuring nails in: 4" Balsam N57E 3.1' mrkd "1/4S NBT" 6" Cherry N11W 15.25' do 8" Balsam N55W 17.0' do 7" Balsam S50W 21.25' do Bearings are magnetic. Distances are to nail with tag.	(E3) Set 5/8" x 18" rebar with plastic cap stamped MICH DNR PS33986. Set measuring nails in: 14" Cedar S88W 53.3' mrkd "S8" * 10" twin Cedar N49W 73.1' mrkd "S5" * 14" twin Cedar N76E 36.35' "S4 NBT" 6" Spruce S70W 44.7' "S8 NBT" Bearings are magnetic. Distances are to nail with tag. * denotes 1968 NBT.
---	---

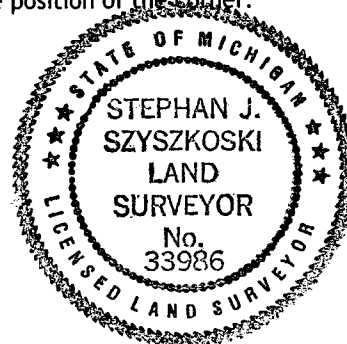

Signed by Stephan J. Szyszkoski
 Surveyor's Michigan License No. 33986

Date 6/6/07

For the Michigan Department of Natural Resources, Office of Land and Facilities