# LAND CORNER RECORDATION CERTIFICATE
## Filing Requirement of Act 74, Mich. P.A. 1970 as Amended

For corners in

Mackinac (County)

| | Located In: | Corner Code # |
|---|---|---|
| 1. Public Land Survey | T 43N R 8W | G4 |
| | T 43N R 8W | G3 |
| | T R | |
| | S T R | |
| 2. Property Controlling | S T R | |
| in Section | S T R | |
| 3. Miscellaneous | S T R | |
| Property in Sec. | S T R | |

Register of Deeds Stamp & File Number

4. Lot No. _____ , Recorded Plat_____

5. Private Claims

G3 Apr 24 2007
G4 Apr 26 2007

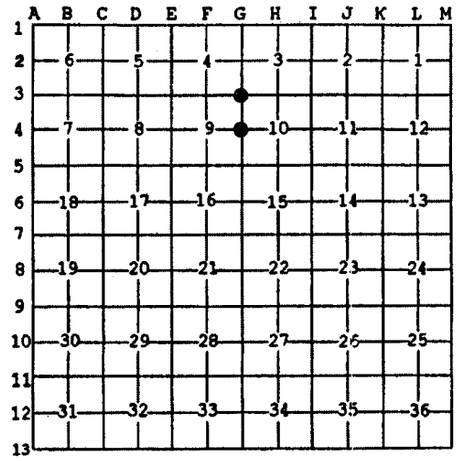


I, Stephan J. Szyszkoski, in a field survey on _____, 20____ do hereby state that under requirements of P.A. 74, Michigan P.A. of 1970, the corner points mentioned in lines 1 and 2 above were in conformance with regulations and rules therefore as required in the current manual of survey instructions of the United States Department of the Interior, Bureau of Land Management or by a decree of a Court of Law and /or that the corner points mentioned in lines 3, 4 and 5 above were in conformance with the rules of the Michigan Board of Land Surveyors or by a Decree of a Court of Law; established, re-established, monumented, recovered, found as expressed below:

**NOTE: Not more than 2 corners, all in the same town and range, may be recorded on this certificate.**

A. Description of original monument and accessories and/or subsequent restoration:

(G4) Quarter corner common to Sections 9-10. 1968 - Billy D. Buckler RLS states: "This corner re-established midway and on line between two Sec. Corners". 1974 - Billy D. Bukcler states: "Moved corner 61.79' north of former position. 1" pipe with 4" aluminum cap. 8" Cedar N23W 6.2', Twin Cedar S34W 4.5'." The corner was moved in 1974 to compensate for a 100' measuring error in the 1968 survey.
(G3) Corner common to Sections 3-4-9-10. 1968 - record of Billy D. Buckler RLS states: "This corner reestablished between corners to north and south..." Set 1" pipe with 4" aluminum cap". 1974 - record of Billy D. Buckler RLS states: "Moved corner 74.15' north of here to correct a 100' error. 11" W.Birch S40W 5.2', 8" B.Spruce S15E 21.0'. "

B. Description of corner evidence found and/or method applied in restoring or reestablishing corner:

(G4) Recovered the 1974 monument in good condition and at record bearing and distance from the 1974 witnesses, both in good condition. I found the position of the monument to be 3.0' NE of the midpoint position between adjacent Section corners. I accept the monument as a careful and faithful reestablishment of the position of the original corner.
(G3) Recovered the 1974 monument in good condition and at record bearing and distance from the 1974 NBTs. The W.Birch is in good condition with overgrown blaze. The B.Spruce is down. I accepted the monument as a careful and faithful reestablishment of the position of the original corner.

C. Description of monument for corner and accessories established to perpetuate locating the position of the corner:

(G4) Found 1"ID I.pipe with 4" alum MDNR cap. Set measuring nails in:
10" Cedar N25W 6.5' mrkd "1/4S" *
8" twin Cedar S33W 4.95' do *
5" Cedar N58E 4.18 mrkd "1/4S NBT"
6" Cedar S35E 8.7' do
Bearings are magnetic. Distances are to nail with tag. * denotes 1974 NBT.

(G3) Found 1"ID I.pipe with 4" alum. MDNR cap. Set measuring nails in:
12" W.Birch S45W 5.5' mrkd "S9" *
4" Cherry N22W 2.9' mrkd "S4 NBT"
5" Balsam S11W 17.45' "S9 NBT"
6" Balsam S79E 22.9' "S10 NBT"
Bearings are magnetic. Distances are to nail with tag. * denotes 1974 NBT.

STATE OF MICHIGAN
STEPHAN J. SZYSZKOSKI
LAND SURVEYOR
No. 33986
LICENSED LAND SURVEYOR

Signed by Stephan J. Szyszkoski Date 6/6/07

Surveyor's Michigan License No. 33986

For the Michigan Department of Natural Resources, Office of Land and Facilities

FORM APPROVED BY MICHIGAN STATE BOARD OF PROFESSIONAL SURVEYORS, JAN. 28, 1971
Revised May 14, 1975
Revised Jan., 1983
Rervised Oct., 1995