

**LAND CORNER RECORDATION CERTIFICATE**  
**Filing Requirement of Act 74, Mich. P.A. 1970 as Amended**

For corners in

<u>Mackinac</u> (County)	Located In:	Corner Code #
1. Public Land Survey	T ___ R ___	_____
	T ___ R ___	_____
	T ___ R ___	_____
	S ___ T ___ R ___	_____
2. Property Controlling in Section	S 9 T 43N R 8W	4
	S 9 T 43N R 8W	8
3. Miscellaneous Property in Sec.	S ___ T ___ R ___	_____
	S ___ T ___ R ___	_____

**Register of Deeds Stamp & File Number**

4. Lot No. \_\_\_\_\_, Recorded Plat \_\_\_\_\_
5. Private Claims
- 8 Apr 26 2007  
4 Apr 24 2007

I, Stephan J. Szyszkoski, in a field survey on \_\_\_\_\_, 20\_\_ do hereby state that under requirements of P.A. 74, Michigan P.A. of 1970, the corner points mentioned in lines 1 and 2 above were in conformance with regulations and rules therefore as required in the current manual of survey instructions of the United States Department of the Interior, Bureau of Land Management or by a decree of a Court of Law and /or that the corner points mentioned in lines 3, 4 and 5 above were in conformance with the rules of the Michigan Board of Land Surveyors or by a Decree of a Court of Law; established, re-established, monumented, recovered, found as expressed below:

	A	B	C	D	E	F	G	H	I	J	K	L	M
1													
2	6		5			4		3		2			1
3													
4	7		8		●	●	9	10		11			12
5													
6	18		17			16		15		14			13
7													
8	19		20			21		22		23			24
9													
10	30		29			28		27		26			25
11													
12	31		32			33		34		35			36
13													

**NOTE: Not more than 2 corners, all in the same town and range, may be recorded on this certificate.**

**A. Description of original monument and accessories and/or subsequent restoration:**


- (4-Sec. 9) Northwest 1/16 corner, Section 9. Not established in the original survey.  
 (8-Sec. 9) West 1/16 corner, Section 9. Not established in the original survey.

**B. Description of corner evidence found and/or method applied in restoring or reestablishing corner:**

- (4-Sec. 9) Established the corner at the intersection of straight lines connecting opposite 1/16 corners.  
 (8-Sec. 9) Established the corner midway and on a straight line between Quarter corner 1314.65' west and Center of Section 1314.65' east.

**C. Description of monument for corner and accessories established to perpetuate locating the position of the corner:**

- |   |   |
|---|---|
| (4) Set 1"IDx36" I.pipe with 4" alum.<br>MDNR cap. Set measuring nails in:<br>5" Spruce S20E 39.17' mrkd "NW1/16 BT"<br>6" Spruce S07W 32.68' do<br>6" Spruce S63W 27.58' do<br>7" Spruce West 22.05 do | (8) Set 1"IDx36" I.pipe with 4" alum.<br>MDNR cap. Set measuring nails in:<br>5" Balsam S30E 7.76' mrkd "W1/16 BT"<br>6" Spruce S50W 12.82' do<br>7" Balsam N46E 28.02' do<br>5" Maple S71E 15.03' do |
| Bearings are magnetic. Distances are to nail with tag.  | Bearings are magnetic. Distances are to nail with tag.  |

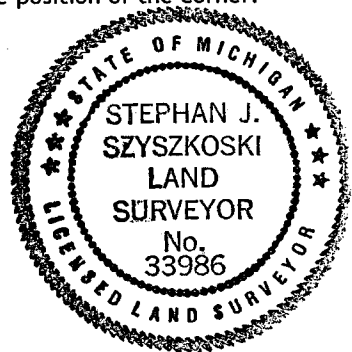

Signed by Stephan J. Szyszkoski  
 Surveyor's Michigan License No. 33986

Date 6/6/07

For the Michigan Department of Natural Resources, Office of Land and Facilities