

# LAND CORNER RECORDATION CERTIFICATE

FILING REQUIREMENT OF ACT 74, MICH. P.A. 1970  
Mackinac Co. 3 Corners.

FOR CORNERS OF--	LOCATED IN--	CORNER CODE NUMBER
1. PUBLIC LAND SURVEY _____ T. _____	N. _____ E. _____ S., R. _____ W.	_____
2. PROPERTY CONTROLLING IN SECTION <u>27</u> T. <u>43</u>	N. _____ E. _____ <del>R.</del> , R. <u>12</u> W.	<u>12, 13, 16</u>
3. MISCELLANEOUS PROPERTY IN SECTION _____ T. _____	N. _____ E. _____ S., R. _____ W.	_____
4. LOT NO. _____, RECORDED PLAT _____		
5. PRIVATE CLAIMS _____		

REGISTER OF DEEDS STAMP AND  
FILING NUMBER

I, Gerald L. Wiggins, do hereby certify that under requirements of P.A. 74, Michigan P.A. of 1970, the corner points mentioned in lines 1 and 2 above were, in a field survey on 8-11, 1987, established, re-established, monumented, re-monumented, recovered or restored as expressed below and in conformance with regulations and rules therefore as required in the current manual of survey instructions of the United States Department of the Interior, Bureau of Land Management or by a decree of a court of law. Furthermore, that the corner points mentioned in lines 3, 4 and 5 above were, in a field survey on \_\_\_\_\_, 19\_\_\_\_, found, recovered, restored, established or re-established as expressed below and in conformance with the rules of the Michigan State Board of Registration for Land Surveyors or, by a Decree of a Court of law:

A. Description of original monument and accessories and/or subsequent restoration:

- 12 South 1/16 Corner of Section 27. Not previously set.
- 13 S.E. 1/16 Corner of Section 27. Not previously set.
- 16 East 1/16 Corner on South side of Section 27. Not previously set.

B. Description of corner evidence found and/or method applied in restoring or re-establishing corner:

- 12 Corner set M.P.O.L. between Center Corner and South 1/4 Corner of Section 27.
- 13 Corner set at center of S.E. 1/4 of Section 27 by closed traverse.
- 16 Corner set M.P.O.L. between South 1/4 Corner and S.E. Corner of Section 27.

C. Description of monument for corner and accessories established to perpetuate locating the position of the corner:

DNR Monument set at all three corners.


- |                             |                              |                             |
|-----------------------------|------------------------------|-----------------------------|
| 12 9" W. Birch, N48°E, 8.3' | 13 7" Tamarack, S55°E, 71.3' | 16 Power Pole, N63°W, 41.5' |
| 6" Balm, S60°E, 8.7'        | 3" Spruce, S5°E, 27.4'       | 6" W. Birch, S58°E, 15.4'   |
| 6" Balm, S50°W, 9.1'        | 6" W. Pine, S70°W, 99.8'     | 5" W. Birch, S35°W, 38.2'   |
| 7" Balm, N60°W, 10.6'       | 4" Spruce, N50°W, 51.2'      | 7" Aspen, N50°W, 62.4'      |
- Cor. lies on southedge of power line clearing.

SIGNED BY \_\_\_\_\_

*Gerald L. Wiggins*  
Gerald L. Wiggins

DATE 9-8-87

SURVEYOR'S MICHIGAN REGISTRATION NO. 23521

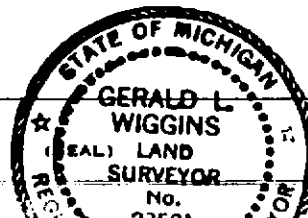

FOR STATE AND UNITED STATES AGENCIES: