

MAY 20 1997

MACKINAC COUNTY REMONUMENTATION CORNER

COMMISSION

LAND CORNER RECORDATION CERTIFICATE
Filing Requirement of Act 74, Mich. P.A. 1970

For corners in
MACKINAC

Located In: Corner Code #

(County)

- 1. Public Land Survey T 43N R 12W M-2
T _____ R _____
T _____ R _____
T _____ R _____
- 2. Property Controlling S _____ T _____ R _____
in Section S _____ T _____ R _____
- 3. Miscellaneous S _____ T _____ R _____
Property in Sec. S _____ T _____ R _____

RECEIVED & FILED
DIANE FRANKOVICH
MACKINAC COUNTY REGISTER OF DEEDS

NOV 15 1996
AM PM
7|8|9|10|11|12|1|2|3|4|5|6

Register of Deeds Stamp & File Number

4. Lot No. _____, Recorded Plat _____

5. Private Claims _____

I, JAMES H. GRANGER, in a field survey on AUGUST 28, 1996 do hereby state that under requirements of P.A. 74, Michigan P.A. of 1970, the corner points mentioned in lines 1 and 2 above were in conformance with regulations and rules therefore as required in the current manual of survey instructions of the United States Department of the Interior, Bureau of Land Management or by a decree of a Court of Law and /or that the corner points mentioned in lines 3, 4 and 5 above were in conformance with the rules of the Michigan Board of Land Surveyors or by a Decree of a Court of Law; established, re-established, monumented, recovered, found as expressed below:

	A	B	C	D	E	F	G	H	I	J	K	L	M
1													
2		6		5		4		3		2		1	
3													
4		7		8		9		10		11		12	
5													
6		16		17		16		15		14		13	
7													
8		19		20		21		22		23		24	
9													
10		30		29		28		27		26		25	
11													
12		31		32		33		34		35		36	
13													

NOTE: Not more than 2 corners, all in the same town and range, may be recorded on this certificate.

A. Description of original monument and accessories and/or subsequent restoration:

- 1841 - Original Survey Set wood post 8" Hemlock S47°W 9lks
W. Burt 8" Cedar N16°E 17lks
- 1986 - LCRC 1" pipe
Gerald Wiggins # 23521

B. Description of corner evidence found and/or method applied in restoring or reestablishing corner:

Found 1/2" iron with cap # 31591 and four witnesses.


ACCEPTED BY THE MACKINAC COUNTY
SURVEY PEER GROUP AS THE
OFFICIAL CORNER UNDER P.A.
345 OF 1990 AT A MEETING
HELD ON 8-20-96

C. Description of monument for corner and accessories established to perpetuate locating the position of the corner

also corner **A-2, T43N, R11W**

Set 5/8" X 30" rebar with Remonumentation Cap in Monument box

- 12" Cedar S58°W 49.15' Fd. tag #31591
- 4" Cedar N80°W 46.25' Fd. tag #31591
- 10" Cedar N75°E 73.50' Fd. tag #31591
- 12" Cedar S78°E 65.90' Fd. tag #31591

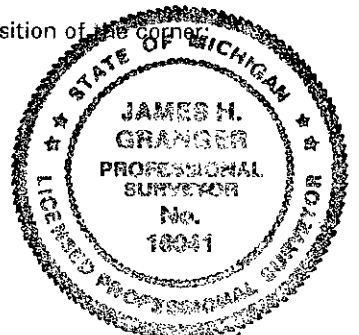

Signed by James H. Granger
Surveyor's Michigan License No. 16041

Date 10-10-96

E 0108