

MACKINAC COUNTY REMONUMENTATION CORNER

MAY 20 1997

LAND CORNER RECORDATION CERTIFICATE
Filing Requirement of Act 74, Mich. P.A. 1970

COMMISSION

For corners in
MACKINAC

Located In: Corner Code #

(County)

1. Public Land Survey T 43N R 12W M-5
 T _____ R _____
 T _____ R _____
 T _____ R _____

2. Property Controlling S _____ T _____ R _____
 in Section S _____ T _____ R _____

3. Miscellaneous S _____ T _____ R _____
 Property in Sec. S _____ T _____ R _____

RECEIVED & FILED
 DIANE BRAT KOVICH
 MACKINAC COUNTY REGISTRE OF DEEDS

NOV 10 1996
 AM _____ PM _____
 7|8|9|10|11|12|1|2|3|4|5|6

Register of Deeds Stamp & File Number

4. Lot No. _____, Recorded Plat _____

5. Private Claims _____

I, JAMES H. GRANGER, in a field survey on October 2, 19 96
 do hereby state that under requirements of P.A. 74, Michigan P.A. of 1970, the corner points
 mentioned in lines 1 and 2 above were in conformance with regulations and rules therefore as
 required in the current manual of survey instructions of the United States Department of the Interior,
 Bureau of Land Management or by a decree of a Court of Law and /or that the corner points
 mentioned in lines 3, 4 and 5 above were in conformance with the rules of the Michigan Board of
 Land Surveyors or by a Decree of a Court of Law; established, re-established, monumented,
 recovered, found as expressed below:

A	B	C	D	E	F	G	H	I	J	K	L	M
1												
2	6		5		4		3		2		1	
3												
4	7		8		9		10		11		12	
5												
6	16		17		16		15		14		13	
7												
8	19		20		21		22		23		24	
9												
10	30		29		28		27		26		25	
11												
12	31		32		33		34		35		36	
13												

NOTE: Not more than 2 corners, all in the same town and range, may be recorded on this certificate.


A. Description of original monument and accessories and/or subsequent restoration:

- 1841 - Original Survey Set wood post 10" Ironwood S52°E 22 lks
 W. Burt 14" Aspen N30°W 42 lks
- 1961 - Survey Steel Pin 1989 - Survey Railroad Spike
 Franklyn Burgess # 2531 Neil Livasy # 31611
- 1974 - LCRC Railroad Spike **ACCEPTED BY THE MACKINAC COUNTY**
 Jerry Wilcox # 14102 **SURVEY PEER GROUP AS THE**
OFFICIAL CORNER UNDER P.A.
345 OF 1990 AT A MEETING
HELD ON 9-30-96
- 1980 - LCRC 1/2" iron
 Thomas O'Brian # 21274

James H. Granger

B. Description of corner evidence found and/or method applied in restoring or reestablishing corner:

Found 1/2" iron with cap #31591, three O'Brian witnesses and four Fabis witnesses.

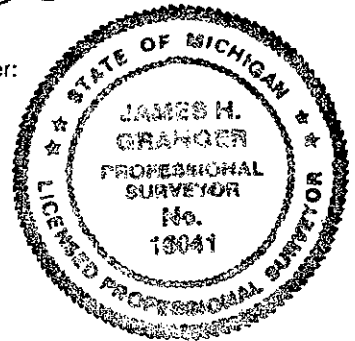

C. Description of monument for corner and accessories established to perpetuate locating the position of the corner:

also corner A-5, T43N, R11W

Set 5/8" X 30" rebar with Remonumentation Cap in Monument box

Power Pole	S62°E	59.19'	Fd. tag #31591	Centerline Monument Box	S10°E	34.72'
10" Ash	N56°W	64.73'	Fd. tag #31591			
NE Corner of House	N50°W	94.11'				
4" Ash	N85°E	72.25'	Fd. tag #31591			

Signed by James H. Granger
 Surveyor's Michigan License No. 16041

Date 10-10-96