

MAY 20 1997

MACKINAC COUNTY REMONUMENTATION CORNER

COMMISSION

LAND CORNER RECORDATION CERTIFICATE
Filing Requirement of Act 74, Mich. P.A. 1970

For corners in
MACKINAC

Located In: Corner Code #

(County)

- 1. Public Land Survey T 43N R 12W M-7
T _____ R _____
T _____ R _____
T _____ R _____
- 2. Property Controlling S _____ T _____ R _____
in Section S _____ T _____ R _____
- 3. Miscellaneous S _____ T _____ R _____
Property in Sec. S _____ T _____ R _____

RECEIVED & FILED
DIANE FRANKOVICH
MACKINAC COUNTY REGISTER OF DEEDS

NOV 15 1996
AM PM
7|8|9|10|11|12|1|2|3|4|5|6

Register of Deeds Stamp & File Number

4. Lot No. _____, Recorded Plat _____

5. Private Claims _____

I, JAMES H. GRANGER, in a field survey on AUGUST 29, 19 96
do hereby state that under requirements of P.A. 74, Michigan P.A. of 1970, the corner points mentioned in lines 1 and 2 above were in conformance with regulations and rules therefore as required in the current manual of survey instructions of the United States Department of the Interior, Bureau of Land Management or by a decree of a Court of Law and /or that the corner points mentioned in lines 3, 4 and 5 above were in conformance with the rules of the Michigan Board of Land Surveyors or by a Decree of a Court of Law; established, re-established, monumented, recovered, found as expressed below:

NOTE: Not more than 2 corners, all in the same town and range, may be recorded on this certificate.

	A	B	C	D	E	F	G	H	I	J	K	L	M
1													
2	6		5		4		3		2		1		
3													
4	7		8		9		10		11		12		
5													
6	18		17		16		15		14		13		
7													
8	19		20		21		22		23		24		
9													
10	30		29		28		27		26		25		
11													
12	31		32		33		34		35		36		
13													

A. Description of original monument and accessories and/or subsequent restoration:

- 1841 - Original Survey Set wood post 16" Cedar S46°E 30 lks
W. Burt 8" Cedar S83°W 32 lks
- 1986 - Survey Eino Saino # 7873

B. Description of corner evidence found and/or method applied in restoring or reestablishing corner:

Found 1" axle and 4" squared cedar post


ACCEPTED BY THE MACKINAC COUNTY SURVEY PEER GROUP AS THE OFFICIAL CORNER UNDER P.A. 345 OF 1990 AT A MEETING HELD ON 8-20-96
James H. Granger

C. Description of monument for corner and accessories established to perpetuate locating the position of the corner:

also corner A-7, T43N, R11W

Set 5/8" X 30" rebar with Remonumentation Cap

- 8" Cedar N33°W 8.44' Set tag
- 8" Cedar S72°E 17.54' Set tag
- 6" Cedar S31°E 19.70' Set tag
- 10" Cedar S40°W 11.45' Set tag

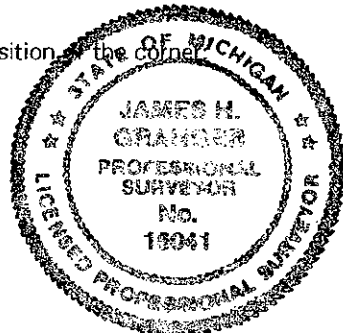

Signed by *James H. Granger*
Surveyor's Michigan License No. 16041

Date 10-10-96