

MACKINAC COUNTY REMONUMENTATION CORNER

MAY 20 1997

LAND CORNER RECORDATION CERTIFICATE
Filing Requirement of Act 74, Mich. P.A. 1970

For corners in COMMISSION
MACKINAC

	Located In:	Corner Code #
(County)		
1. Public Land Survey	T <u>43N</u> R <u>12W</u>	<u>M-8</u>
	T ___ R ___	_____
	T ___ R ___	_____
	T ___ R ___	_____
2. Property Controlling	S ___ T ___ R ___	_____
in Section	S ___ T ___ R ___	_____
3. Miscellaneous	S ___ T ___ R ___	_____
Property in Sec.	S ___ T ___ R ___	_____

RECEIVED & FILED
DIANE FRANKOVICH
MACKINAC COUNTY REGISTER OF DEEDS

NOV 15 1996
AM PM
7|8|9|10|11|12|1|2|3|4|5|6

Register of Deeds Stamp & File Number

4. Lot No. _____, Recorded Plat _____
5. Private Claims _____

I, JAMES H. GRANGER, in a field survey on AUGUST 29, 19 96
do hereby state that under requirements of P.A. 74, Michigan P.A. of 1970, the corner points mentioned in lines 1 and 2 above were in conformance with regulations and rules therefore as required in the current manual of survey instructions of the United States Department of the Interior, Bureau of Land Management or by a decree of a Court of Law and /or that the corner points mentioned in lines 3, 4 and 5 above were in conformance with the rules of the Michigan Board of Land Surveyors or by a Decree of a Court of Law; established, re-established, monumented, recovered, found as expressed below:

A	B	C	D	E	F	G	H	I	J	K	L	M
1												
2	6		5		4		3		2		1	
3												
4	7		8		9		10		11		12	
5												
6	18		17		16		15		14		13	
7												
8	19		20		21		22		23		24	
9												
10	30		29		28		27		26		25	
11												
12	31		32		33		34		35		36	
13												

NOTE: Not more than 2 corners, all in the same town and range, may be recorded on this certificate.

A. Description of original monument and accessories and/or subsequent restoration:

1841 - Original Survey Set wood post 6" Spruce S20°E 15 lks
W. Burt 5" Tamarack S20°W 15 lks

ACCEPTED BY THE MACKINAC COUNTY
SURVEY PEER GROUP AS THE
OFFICIAL CORNER UNDER P.A.
345 OF 1990 AT A MEETING
HELD ON 8-20-96

B. Description of corner evidence found and/or method applied in restoring or reestablishing corner:

Found no evidence. Placed corner by single proportionate measure between the NE and SE section corners.


James H. Granger

C. Description of monument for corner and accessories established to perpetuate locating the position of the corner:

also corner **A-8, T43N, R11W**

Set 5/8" X 30" rebar with Remonumentation Cap

10" Poplar	N52°E	23.78'	Set tag
10" Spruce	S22°E	17.58'	Set tag
10" Birch	S10°E	19.55'	Set tag
4" Balsam	N77°W	19.85'	Set tag

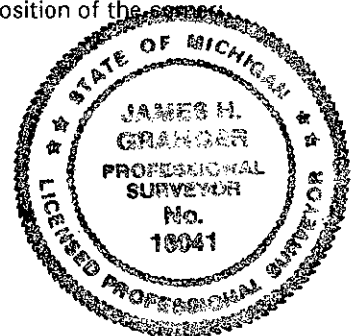

Signed by James H. Granger
Surveyor's Michigan License No. 16041

Date 10-10-96