

REMONUMENTATION MACKINAC COUNTY REMONUMENTATION CORNER

MAY 20 1997

LAND CORNER RECORDATION CERTIFICATE
Filing Requirement of Act 74, Mich. P.A. 1970

For corners in
MACKINAC COUNTY

Located In: Corner Code #

1. Public Land Survey T 43N R 12W M-9
 T _____ R _____
 T _____ R _____
 T _____ R _____
2. Property Controlling S _____ T _____
 in Section S _____ T _____
 3. Miscellaneous S _____ T _____
 Property in Sec. S _____ T _____

RECEIVED & FILED
 DIANE FRAT KOVICH
 MACKINAC COUNTY REGISTER OF DEEDS
 NOV 15 1996
 AM _____ PM _____
 7|8|9|10|11|12|1|2|3|4|5|6
 Register of Deeds Stamp & File Number

4. Lot No. _____, Recorded Plat _____
 5. Private Claims _____

1	A	B	C	D	E	F	G	H	I	J	K	L	M
2	6		5		4		3		2		1		
3													
4	7		8		9		10		11		12		
5													
6	18		17		16		15		14		13		
7													
8	19		20		21		22		23		24		
9													
10	30		29		28		27		26		25		
11													
12	31		32		33		34		35		36		
13													

I, JAMES H. GRANGER, in a field survey on AUGUST 29, 1996
do hereby state that under requirements of P.A. 74, Michigan P.A. of 1970, the corner points mentioned in lines 1 and 2 above were in conformance with regulations and rules therefore as required in the current manual of survey instructions of the United States Department of the Interior, Bureau of Land Management or by a decree of a Court of Law and /or that the corner points mentioned in lines 3, 4 and 5 above were in conformance with the rules of the Michigan Board of Land Surveyors or by a Decree of a Court of Law; established, re-established, monumented, recovered, found as expressed below:

NOTE: Not more than 2 corners, all in the same town and range, may be recorded on this certificate.

A. Description of original monument and accessories and/or subsequent restoration:

1841 - Original Survey Set wood post 14" Sugar S37°E 34 lks
 W. Burt 20" Ash S47°W 34 lks

1990 - LCRC 1/2" re-rod
 Neil Hill # 27447

ACCEPTED BY THE MACKINAC COUNTY
 SURVEY PEER GROUP AS THE
 OFFICIAL CORNER UNDER P.A.
 345 OF 1990 AT A MEETING
 HELD ON 8-20-96

James H. Granger

B. Description of corner evidence found and/or method applied in restoring or reestablishing corner:


Found 1/2" iron with cap # 27442 and five witnesses.

C. Description of monument for corner and accessories established to perpetuate locating the position of the corner:

also corner A-9, T43N, R11W

Set 5/8" X 30" rebar with Remonumentation Cap in Monument box

- Light Pole S 25°E 81.85' Fd. MDOT tag
 T Pole N65°W 56.50' Fd. MDOT tag
 GDS N70°W 72.11'
 Concrete Marker N45°E 43.66'
 SW Bolt Superior
 Gas Sign N70°E 99.59'

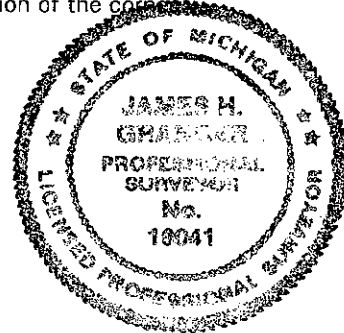

Signed by James H. Granger
 Surveyor's Michigan License No. 16041

Date 10-10-96