

LAND CORNER RECORDATION CERTIFICATE
Filing Requirement of Act 74, Mich. P.A. 1970 as Amended

For corners in

Mackinac
 (County)

Located In:

Corner Code #

1. Public Land Survey	T	R	_____
	T	R	_____
	T	R	_____
2. Property Controlling in Section	S	T	R
	S 5	T 43N	R 12W
	S 5	T 43N	R 12W
			2
			8
3. Miscellaneous Property in Sec.	S	T	R
	S	T	R

Register of Deeds Stamp & File Number

4. Lot No. _____, Recorded Plat _____
 5. Private Claims

8 Dec 15 2003
 2 Oct 08 2003

I, Stephan J. Szyszkoski, in a field survey on _____, 20____ do hereby state that under requirements of P.A. 74, Michigan P.A. of 1970, the corner points mentioned in lines 1 and 2 above were in conformance with regulations and rules therefore as required in the current manual of survey instructions of the United States Department of the Interior, Bureau of Land Management or by a decree of a Court of Law and /or that the corner points mentioned in lines 3, 4 and 5 above were in conformance with the rules of the Michigan Board of Land Surveyors or by a Decree of a Court of Law; established, re-established, monumented, recovered, found as expressed below:

NOTE: Not more than 2 corners, all in the same town and range, may be recorded on this certificate.

A. Description of original monument and accessories and/or subsequent restoration:

(2-Sec. 5) East 1/16 corner between Section 5 T43N-R12W and Section 32 T44N-R12W. Not established in the original survey.
 (8-Sec. 5) West 1/16 corner, Section 5. Not established in the original survey.


B. Description of corner evidence found and/or method applied in restoring or reestablishing corner:

(2-Sec. 5) Established the corner midway and on a line of mean true bearing between Quarter corner 1319.86' West and Section corner 1319.86' East.
 (8-Sec. 5) Established the corner midway and on a straight line between Quarter corner 1318.45' West and the intersection of 1/4 lines 1318.45' East.

C. Description of monument for corner and accessories established to perpetuate locating the position of the corner:

(2) Set 1"IDx36" I.pipe with plastic cap stamped "MICH DNR PS 33986" buried below the surface in the east edge of a N-S trail. Blazed, scribed, and set measuring nails in: 6" Maple N38E 11.4' "E1/16 BT" 12" Ironwood N89W 17.4' do 6" Maple S75E 21.2' do 6" Maple N25W 36.4' do Cedar post 2.0' East. Bearings magnetic. Distances to nail with tag.	(8) Set 1"IDx36" I.pipe with 4" alum. MDNR cap. Blazed, scribed, and set measuring nails in: 8" Cedar N04W 51.25' "W1/16 BT" 12" Cedar N86W 80.8' do 5" Tamarack S38E 15.05' do 4" Tamarack N68E 16.15' do Bearings are magnetic. Distances are to nail with tag.
---	--

A	B	C	D	E	F	G	H	I	J	K	L	M
1												
2	6		5		4		3		2		1	
3												
4	7		8		9		10		11		12	
5												
6	18		17		16		15		14		13	
7												
8	19		20		21		22		23		24	
9												
10	30		29		28		27		26		25	
11												
12	31		32		33		34		35		36	
13												

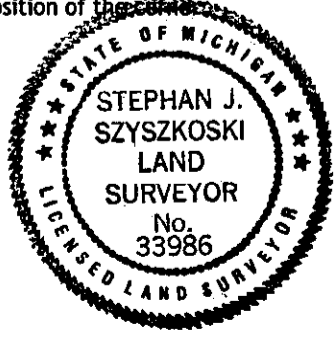

Signed by Stephan J. Szyszkoski
 Surveyor's Michigan License No. 33986

Date 2/17/04