

LAND CORNER RECORDATION CERTIFICATE
Filing Requirement of Act 74, Mich. P.A. 1970 as Amended

For corners in

<u>Mackinac</u> (County)	Located In:	Corner Code #
1. Public Land Survey	T <u>43N</u> R <u>12W</u>	<u>E1</u>
	T _____ R _____	_____
	T _____ R _____	_____
2. Property Controlling in Section	S _____ T <u>43N</u> R <u>12W</u>	<u>7</u>
	S <u>5</u> T _____ R _____	_____
	S _____ T _____ R _____	_____
3. Miscellaneous Property in Sec.	S _____ T _____ R _____	_____
	S _____ T _____ R _____	_____

Register of Deeds Stamp & File Number

4. Lot No. _____, Recorded Plat _____
 5. Private Claims _____

Oct 08 2003

I, Stephan J. Szyszkoski, in a field survey on _____, 20____ do hereby state that under requirements of P.A. 74, Michigan P.A. of 1970, the corner points mentioned in lines 1 and 2 above were in conformance with regulations and rules therefore as required in the current manual of survey instructions of the United States Department of the Interior, Bureau of Land Management or by a decree of a Court of Law and /or that the corner points mentioned in lines 3, 4 and 5 above were in conformance with the rules of the Michigan Board of Land Surveyors or by a Decree of a Court of Law; established, re-established, monumented, recovered, found as expressed below:

	A	B	C	D	E	F	G	H	I	J	K	L	M
1													
2	6			5		4		3		2		1	
3													
4	7			8		9		10		11		12	
5													
6	18			17		16		15		14		13	
7													
8	19			20		21		22		23		24	
9													
10	30			29		28		27		26		25	
11													
12	31			32		33		34		35		36	
13													

NOTE: Not more than 2 corners, all in the same town and range, may be recorded on this certificate.

A. Description of original monument and accessories and/or subsequent restoration:


(E1) Corner common to Sections 4-5 T43N-R12W and Sections 32-33 T44N-R12W. 1841: Established by Wm.A.Burt: Set post corner of Sections 32-33. Fir 7 N33E 27, Fir 8 N75W 29. 1973: J.F.Erickson RLS found and accepted a 2" iron pipe. N30E 26.53' 20" Birch, N60W 24.50' 24" Birch, S45E 23.50' 8" Maple.
 (7-Sec. 5) Not established in the original survey. 1973: Established at 20 chains, proportionate to the original record, north of E2 by J.L.Wilcox, RLS. Not of record.

B. Description of corner evidence found and/or method applied in restoring or reestablishing corner:

(E1) Recovered a 2" ID iron pipe, in good condition and at record bearing and distance from the 1973 NBTs. The two birch NBTs are now stumps with no markings visible. The Maple is in good condition and was remeasured as described below. Accepted the monument as the best available evidence of the position of the original corner.
 (7-Sec. 5) Found 5/8" dia. rebar at the proper position for the corner. Accepted same and placed a plastic cap stamped "MICH DNR PS 33986" on the rebar.

C. Description of monument for corner and accessories established to perpetuate locating the position of the corner:

(E1) Found 2" ID iron pipe. Blazed, scribed, and set measuring nails in:	(7) Found 5/8" dia. rebar. Placed plastic cap #33986 on it. Blazed, scribed, and set measuring nails in:
10" Maple S33E 23.55' "S4 NBT"	8" Balsam N60W 7.0' "N1/16 BT"
8" Cedar S62W 37.2' "S5 NBT"	6" Balsam N38E 5.35' do
8" Maple S25W 25.15' do	5" Maple S85E 6.0' do
14" W.Birch N42W 21.05' "S32 NBT"	10" Balsam N04E 13.6' do
Bearings are magnetic. Distances are to nail with tag.	1/2" pipe S30E 2.4'
	Placed cedar post adjacent. Bearings are magnetic. Distances are to nail with tag.

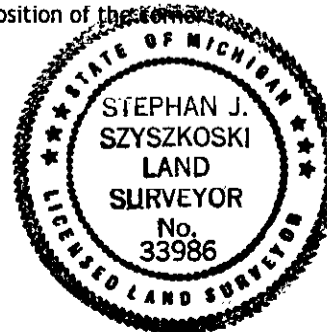

Signed by Stephan J. Szyszkoski
 Surveyor's Michigan License No. 33986

Date 2/17/04

For the Michigan Department of Natural Resources, Office of Land and Facilities