


T43N R02W

Marquette Twp.

JAN 21 1999

SECTION

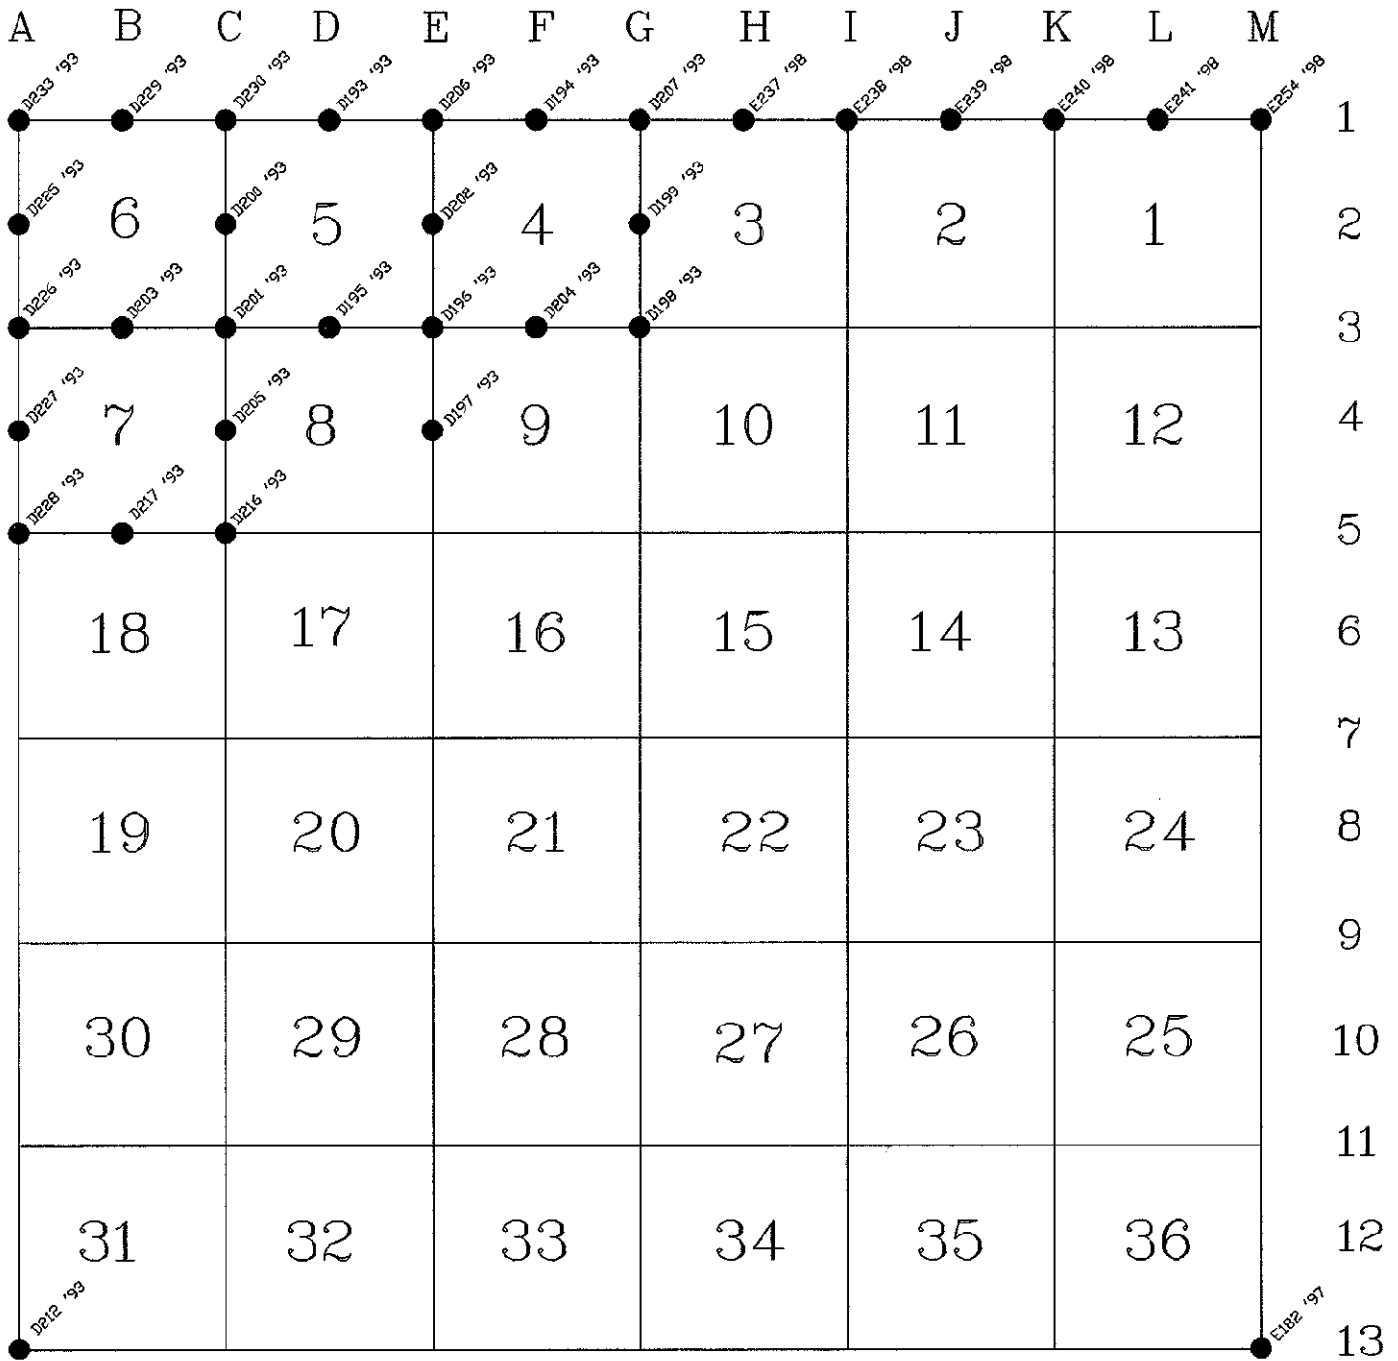

● Denotes Set ReMonumentation Corner in 1998

● Denotes Previously Set ReMonumentation Corner