


# T43N R02W

Marquette Twp.

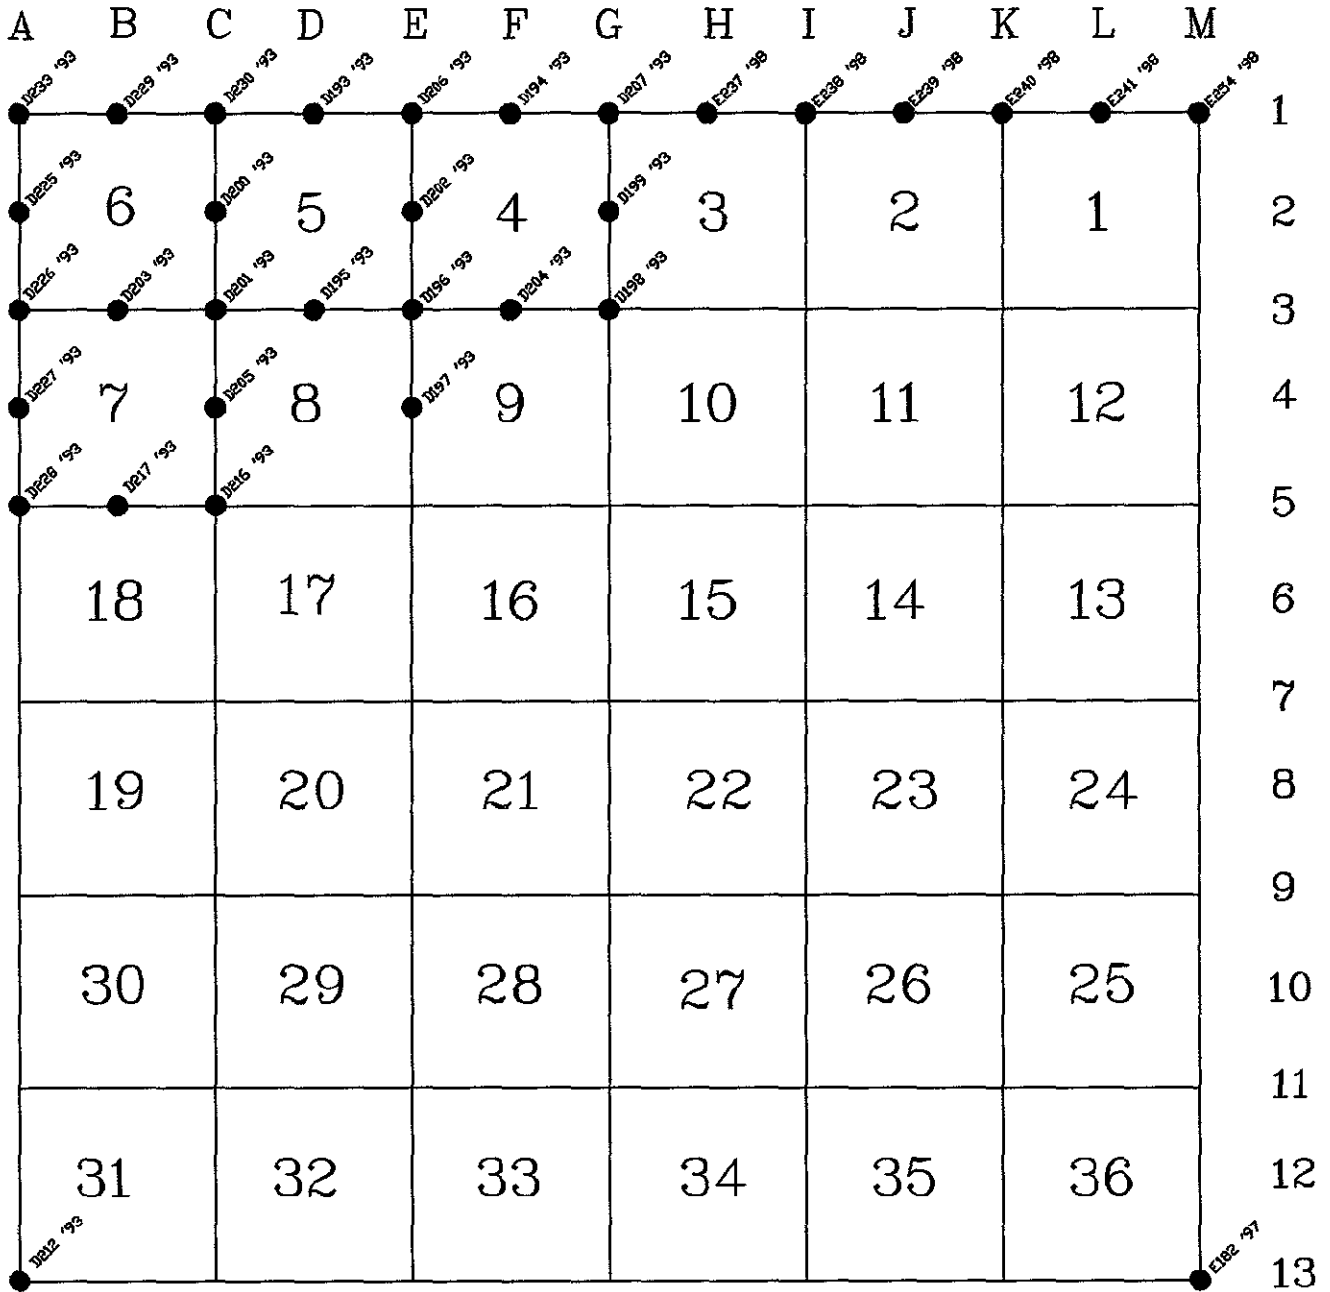

● Denotes Set ReMonumentation Corner in 1998

● Denotes Previously Set ReMonumentation Corner