SURVEY & REMONUMENTATION

FEB 18 1994

COMMISSION

LAND CORNER RECORDATION CERTIFICATE

Filing Requirement of Act 74, Mich. P.A. 1970

For corners in Mackinac (County)

	Located In:	Corner Code ##
1. Public Land Survey	T 43N R 2W	A-1
	T ___ R ___	
	T ___ R ___	
	T ___ R ___	
2. Property Controlling	S ___ T ___ R ___	
in Section	S ___ T ___ R ___	
3. Miscellaneous	S ___ T ___ R ___	
Property in Sec.	S ___ T ___ R ___	

RECEIVED & FILED
DIANE FRAP KOVICH
MACKINAC COUNTY REGISTER OF DEEDS

DEC 07 1995

AM PM

7 8 9 10 11 12 1 2 3 4 5 6

Register of Deeds Stamp & File Number

4. Lot No. _____ , Recorded Plat _____
5. Private Claims _____

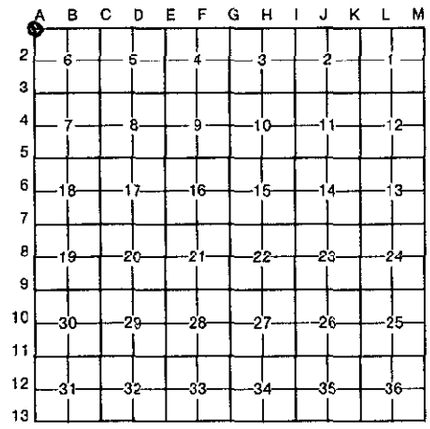

I, Neil E. Hill, *in a field survey on* October 1, 19 93, do hereby certify that under requirements of P.A. 74, Michigan P.A. of 1970, the corner points mentioned in lines 1 and 2 above were in conformance with regulations and rules therefore as required in the current manual of survey instructions of the United States Department of the Interior, Bureau of Land Management or by a decree of a Court of Law and/or that the corner points mentioned in lines 3, 4 and 5 above were in conformance with the rules of the Michigan Board of Land Surveyors or by a Decree of a Court of Law; established, re-established, monumented, re-monumented, recovered, found as expressed below:

NOTE: Not more than 4 corners, all in the same town and range, may be recorded on this certificate.

A. Description of original monument and accessories and/or subsequent restoration:

1840: Established by William A. Burt, in the original government survey of T44N, R02W.
18" Fir S30E 12.54 feet
16" Spruce N50W 17.82 feet

1967: 1" iron pin in monument box recovered by Ray Walker (M.S.H.D.). References established:
3" Poplar S50E 54.98 feet
4" Post S25E 61.87 feet
10" Spruce S70E 75.25 feet

B. Description of corner evidence found and/or method applied in restoring or reestablishing corner:

1983: USDA-Forest Service recovered 1" iron pin in monument box 8.5 feet East of the centerline of Mackinac Trail Road. Also recovered spruce bearing tree from 1967 at S54E from iron pipe. Accepted recovered iron pin as best available evidence of the original corner position.

1983: USDA-Forest Service left iron pin as recovered and established the following references, of which the bearing trees ar blazed, scribed, painted,, and tagged:
Power Pole N81E 125.7 feet
10" Aspen S71W 125.3 feet
Post S65E 24.5 feet
12" Spruce S54E 75.3 feet
8" Red Pine N65W 73.4 feet

C. Description of monument for corner and accessories established to perpetuate locating the position of the corner:

1993: Found 1: iron pin in monument box 8.5 feet East of the centerline of Mackinac Trail Road in old concrete pavement overlaid with bituminous, and following references, of which the bearing trees are blazed, scribed, painted, and tagged:
Power Pole N81E 125.7 feet
10" Aspen S71W 125.3 feet
Post S65E 24.5 feet
12" Spruce S54E 75.3 feet
8" Red Pine N65W 73.4 feet

1993: Replaced with 5/8" X 30" rod with 3" diameter aluminum cap.
Upon review, the location and witnesses for the corner as recorded in Liber C-40 (Corner Records), are sufficient to perpetuate corner location.

Signed by Neil E. Hill P.S. P.C. Date October 15, 1993

Surveyor's Michigan License No. 27447

STATE OF MICHIGAN NEIL E. HILL Land Surveyor No. 27447 REGISTERED LAND SURVEYOR

Remonumentation Surveyor

D-0233

FORM APPROVED BY MICHIGAN STATE BOARD OF LAND SURVEYORS, JAN. 28, 1971
REVISED MAY 14, 1975
REVISED JAN., 1983