SURVEY &
REMONUMENTATION

FEB 1 8 1994

COMMISSION

LAND CORNER RECORDATION CERTIFICATE

Filing Requirement of Act 74, Mich. P.A. 1970

For corners in Mackinac (County)

RECEIVED & FILED
DIANE SRAP KOVICH
MACKINAC COUNTY REGISTER OF DEEDS

DEC 07 1995
AM PM
7|8|9|10|11|12|1|2|3|4|5|6

Register of Deeds Stamp & File Number

		Located In:	Corner Code ##
1. Public Land Survey		T 43NR 2W	A-4
		T R	
		T R	
		T R	
2. Property Controlling	S	T R	
in Section	S	T R	
3. Miscellaneous	S	T R	
Property in Sec.	S	T R	

4. Lot No. _____ , Recorded Plat _____
5. Private Claims _____

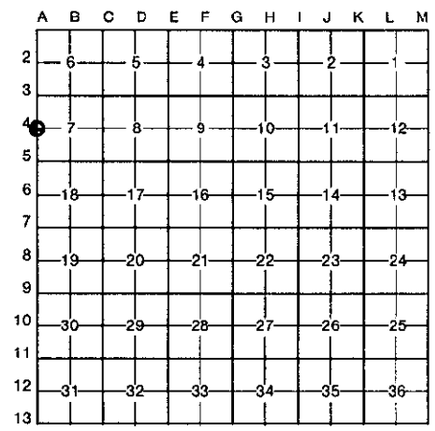

I, Neil E. Hill, in a field survey on October 1, 19 93, do hereby certify that under requirements of P.A. 74, Michigan P.A. of 1970, the corner points mentioned in lines 1 and 2 above were in conformance with regulations and rules therefore as required in the current manual of survey instructions of the United States Department of the Interior, Bureau of Land Management or by a decree of a Court of Law and/or that the corner points mentioned in lines 3, 4 and 5 above were in conformance with the rules of the Michigan Board of Land Surveyors or by a Decree of a Court of Law; established, re-established, monumented, re-monumented, recovered, found as expressed below:

NOTE: Not more than 4 corners, all in the same town and range, may be recorded on this certificate.

A. Description of original monument and accessories and/or subsequent restoration:

1840: Established by Austin Burt, in the original government survey of the range line T43N, R02-03W.
Set a wooden post and established the following references:
10" Fir S13W 34 Links
20" Cedar N44W 7 Links

B. Description of corner evidence found and/or method applied in restoring or reestablishing corner:

1986: ECI, no original corner evidence recovered. Measurements taken Northerly to the L.H. bank of the Pine River do not agree closely with record G.L.O. distances (1345' - ECI: 1419' - G.L.O.). Corner position established at proportionate distance from SE corner of Section 12 and on line between the first M.C. South of the NE Corner of Section 12 and the first M.C. North of the E-1/4 Corner of Section 13.

1986: Alan K. Pierce, L.S. #30097, set a 2-1/2" O.D. x 4' long galvanized iron pipe with a plastic flanged base and capped with a 3-1/4" bronze tablet stamped to identify the corner. Bearing trees are blazed, scribed, painted and tagged with distances being measured from an aluminum nail in the side of the tree.

10" Balsam Poplar	S74E	42.91'	14" Maplewood	S06E	40.31'
7" Balsam Poplar	N86W	9.90'	14" Balsam Poplar	N15W	30.43'
Post	North	2.0 '			

C. Description of monument for corner and accessories established to perpetuate locating the position of the corner:

1993: Found a 2-1/2" O.D. iron pipe capped with a 3-1/4" bronze tablet stamped to identify the corner. Also found following witnesses, of which bearing trees are blazed, scribed, painted and tagged with distances being measured from an aluminum nail in the side of the tree.

10" Balsam Poplar	S74E	42.91'	14" Maplewood	S06E	40.31'
7" Balsam Poplar	N86W	9.90'	14" Balsam Poplar	N15W	30.43'
Post	North	2.0 '			

1993: Upon review, the location and witnesses for the corner as recorded in Liber C-136 (Corner Records), are sufficient to perpetuate corner location.

Signed by Neil E. Hill P.S. P.C. Date October 15, 1993

Surveyor's Michigan License No. 27447

Remonumentation Surveyor

STATE OF MICHIGAN
NEIL E. HILL
Land Surveyor
No. 27447
REGISTERED LAND SURVEYOR

FORM APPROVED BY MICHIGAN STATE BOARD OF LAND SURVEYORS, JAN. 28, 1971
REVISED MAY 14, 1975
REVISED JAN., 1983

D-0227