S 4WQ . 8123 1(4/93 21:10 'A5SW . 8775 : /93 21:
SECTIONS 23938 10/19/93 17:39

FEB 1 8 1994

COMMISSION

LAND CORNER RECORDATION CERTIFICATE

Filing Requirement of Act 74, Mich. P.A. 1970

For corners in Mackinac (County)

RECEIVED & FILED
DIANE FRAN KOVICH
MACKINAC COUNTY REGISTER OF DEEDS
DEC 07 1993
AM PM
7|8|9|10|11|12|1|2|3|4|5|6
Register of Deeds Stamp & File Number

	Located In:	Corner Code #
1. Public Land Survey	T 43N R 2W	B-1
	T ___ R ___	
	T ___ R ___	
	T ___ R ___	
2. Property Controlling	S ___ T ___ R ___	
in Section	S ___ T ___ R ___	
3. Miscellaneous	S ___ T ___ R ___	
Property in Sec.	S ___ T ___ R ___	

4. Lot No. ____, Recorded Plat ____
5. Private Claims ____

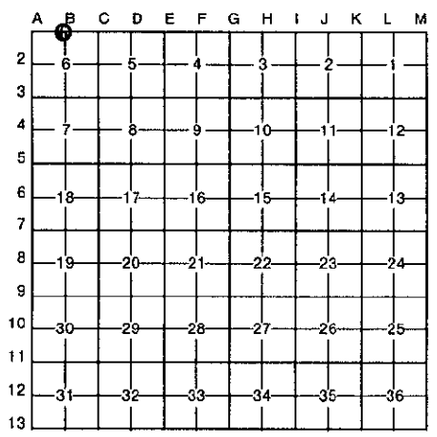

I, Neil E. Hill, in a field survey on October 1, 19 93, do hereby certify that under requirements of P.A. 74, Michigan P.A. of 1970, the corner points mentioned in lines 1 and 2 above were in conformance with regulations and rules therefore as required in the current manual of survey instructions of the United States Department of the Interior, Bureau of Land Management or by a decree of a Court of Law and/or that the corner points mentioned in lines 3, 4 and 5 above were in conformance with the rules of the Michigan Board of Land Surveyors or by a Decree of a Court of Law; established, re-established, monumented, re-monumented, recovered, found as expressed below:

NOTE: Not more than 4 corners, all in the same town and range, may be recorded on this certificate.

A. Description of original monument and accessories and/or subsequent restoration:

1840: Established by William A. Burt, in the original government survey of T43N, R02W. Set a 11" cedar as corner position with no references.

No record found that the corner had been previously recovered or recorded.

B. Description of corner evidence found and/or method applied in restoring or reestablishing corner:

1988: No original or subsequent corner evidence was recovered. The corner position was re-established by the single proportionate measurement on the line between the recovered Northwest Corner of Section 6, and the re-established Northeast Corner of Section 6.

1989: A 2-1/2" x 3' aluminum monument with a 3" aluminum cap stamped to identify the corner was set by Richard L. Hays L.S.#25847. Monument was set 1" above the ground with the distance taken to nail blaze. Established the following references, of which the bearing trees are blazed, scribed and painted red:

7" Maple	S71E	22.16 feet	9" Spruce	S83W	22.41 feet
4" Spruce	N65W	13.98 feet	Cedar Post	East	1.50 feet

C. Description of monument for corner and accessories established to perpetuate locating the position of the corner:

1993: Found a 2-1/2" x 3' aluminum monument with a 3" aluminum cap stamped to identify the corner . The following references, of which the bearing trees are blazed, scribed and painted red were found:

7" Maple	S71E	22.16 feet	9" Spruce	S83W	22.41 feet (nail grown over)
4" Spruce	N65W	13.98 feet	Cedar Post	East	1.50 feet

1993: Upon review, the location and witnesses for the corner as recorded in Liber D-0028 (Corner Records), are suffiecient to perpetuate corner location.

Signed by Neil E. Hill P.S. P.C. Date October 15, 1993

Surveyor's Michigan License No. 27447

STATE OF MICHIGAN NEIL E. HILL Land Surveyor No. 27447 REGISTERED LAND SURVEYOR

Remonumentation Surveyor

D-0229

FORM APPROVED BY MICHIGAN STATE BOARD OF LAND SURVEYORS, JAN. 28, 1971
REVISED MAY 14, 1975
REVISED JAN., 1983