SURVEY & REMONUMENTATION COMMISSION
FEB 18 1994

MACKINAC COUNTY REMONUMENTATION CORNER
LAND CORNER RECORDATION CERTIFICATE
Filing Requirement of Act 74, Mich. P.A. 1970

For corners in Mackinac (County)

	Located In:	Corner Code ##
1. Public Land Survey	T 43N R 2W	B-5
	T ___ R ___	
	T ___ R ___	
	T ___ R ___	
2. Property Controlling	S ___ T ___ R ___	
in Section	S ___ T ___ R ___	
3. Miscellaneous	S ___ T ___ R ___	
Property in Sec.	S ___ T ___ R ___	

RECEIVED & FILED
DIANE FRANKOVICH
MACKINAC COUNTY REGISTER OF DEEDS
DEC 06 1993
AM PM
7 8 9 10 11 12 1 2 3 4 5 6
Register of Deeds Stamp & File Number

4. Lot No. _____ , Recorded Plat _____
5. Private Claims _____

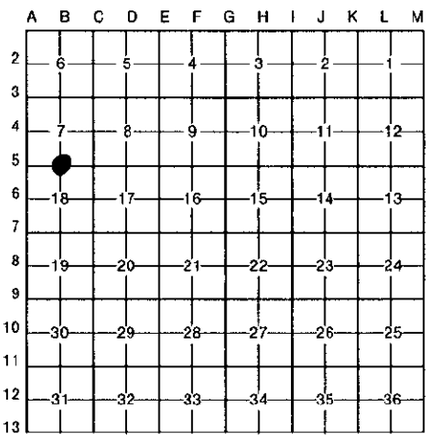

I, James H. Granger, in a field survey on November 10-24, 19 93, do hereby certify that under requirements of P.A. 74, Michigan P.A. of 1970, the corner points mentioned in lines 1 and 2 above were in conformance with regulations and rules therefore as required in the current manual of survey instructions of the United States Department of the Interior, Bureau of Land Management or by a decree of a Court of Law and/or that the corner points mentioned in lines 3, 4 and 5 above were in conformance with the rules of the Michigan Board of Land Surveyors or by a Decree of a Court of Law; established, re-established, monumented, re-monumented, recovered, found as expressed below:

NOTE: Not more than 4 corners, all in the same town and range, may be recorded on this certificate.

A. Description of original monument and accessories and/or subsequent restoration:

1845 Original Survey James H. Mullett
6" Hemlock for corner

1989 USFS Richard Hays #25847

B. Description of corner evidence found and/or method applied in restoring or reestablishing corner:

Fd 1989 monument
Found four 1989 witnesses

STATE OF MICHIGAN
JAMES H. GRANGER
PROFESSIONAL SURVEYOR
No. 16041
LICENSED PROFESSIONAL SURVEYOR

C. Description of monument for corner and accessories established to perpetuate locating the position of the corner:

2½" pipe with alum. cap

8" Spruce	West	45.98'	Fd nail
6" Maple	N 32° E	98.41'	Fd nail
6" Maple	S 56° W	30.29'	nail overgrown - set nail & tag PS #16041
Post	East	1.50'	
11" Aspen	S 55° E	28.19'	nail & tag PS #16041

Signed by James H Granger Date Dec. 3, 1993

Surveyor's Michigan License No. 16041

FORM APPROVED BY MICHIGAN STATE BOARD OF LAND SURVEYORS, JAN. 28, 1971
REVISED MAY 14, 1975
REVISED JAN., 1983

D-217