

SURVEY &
RECORDATION

FEB 18 1994

COMMISSION

**MACKINAC COUNTY REMONUMENTATION CORNER
LAND CORNER RECORDATION CERTIFICATE
Filing Requirement of Act 74, Mich. P.A. 1970**

For corners in

<u>Mackinac</u> <small>(County)</small>	Located In:	Corner Code #
1. Public Land Survey	T <u>43N</u> R <u>2W</u>	<u>C-5</u>
	T _____ R _____	_____
	T _____ R _____	_____
	T _____ R _____	_____
2. Property Controlling in Section	S _____ T _____ R _____	_____
	S _____ T _____ R _____	_____
3. Miscellaneous Property in Sec.	S _____ T _____ R _____	_____
	S _____ T _____ R _____	_____
4. Lot No. _____, Recorded Plat _____		
5. Private Claims _____		

RECEIVED & FILED
DIANE FRANKOVICH
MACKINAC COUNTY REGISTER OF DEEDS

DEC 06 1993
AM _____ PM _____
7|8|9|10|11|12|13|14|15|16

Register of Deeds Stamp & File Number

I, James H. Granger, in a field survey on November 10-24, 19 93, do hereby certify that under requirements of P.A. 74, Michigan P.A. of 1970, the corner points mentioned in lines 1 and 2 above were in conformance with regulations and rules therefore as required in the current manual of survey instructions of the United States Department of the Interior, Bureau of Land Management or by a decree of a Court of Law and/or that the corner points mentioned in lines 3, 4 and 5 above were in conformance with the rules of the Michigan Board of Land Surveyors or by a Decree of a Court of Law; established, re-established, monumented, re-monumented, recovered, found as expressed below:


NOTE: Not more than 4 corners, all in the same town and range, may be recorded on this certificate.

A	B	C	D	E	F	G	H	I	J	K	L	M
2	6	5	4	3	2	1						
3												
4	7	8	9	10	11	12						
5		●										
6	18	17	16	15	14	13						
7												
8	19	20	21	22	23	24						
9												
10	30	29	28	27	26	25						
11												
12	31	32	33	34	35	36						
13												

A. Description of original monument and accessories and/or subsequent restoration:
1845 Original Survey James H. Mullett
Set Wood Post
12" Maple N 21° W 17 lks
10" Fir S 51° E 18 lks
No date MDOT Ray Walker
1989 USFS Richard Hays #25847

B. Description of corner evidence found and/or method applied in restoring or reestablishing corner:
Fd 1989 monument
Found two 1989 witnesses in good condition
Found two 1989 witnesses partially destroyed

C. Description of monument for corner and accessories established to perpetuate locating the position of the corner:
2½" pipe with alum. cap
5" Birch N 48° E 15.23' (15.19' R) Fd nail
11" Aspen N 66° W 19.27'
Set nail & tag PS #16041 in"
8" Aspen S 54° E 16.61'
6" Aspen N 3° W 16.66'

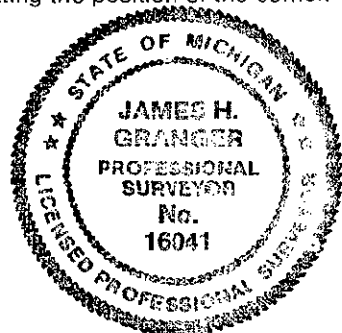

Signed by James H. Granger Date DEC. 3, 1993
Surveyor's Michigan License No. 16041