

1993 Mackinac County Remonumentation Corner

COMMISSION

LAND CORNER RECORDATION CERTIFICATE  
Filing Requirement of Act 74, Mich. P.A. 1970

For corners in

<u>Mackinac</u> <small>(County)</small>	Located In:	Corner Code #
1. Public Land Survey	T <u>43N</u> R <u>2W</u>	<u>D-3</u>
	T _____ R _____	_____
	T _____ R _____	_____
	T _____ R _____	_____
2. Property Controlling in Section	S _____ T _____ R _____	_____
	S _____ T _____ R _____	_____
3. Miscellaneous Property in Sec.	S _____ T _____ R _____	_____
	S _____ T _____ R _____	_____
4. Lot No. _____, Recorded Plat _____		
5. Private Claims _____		

RECEIVED & FILED  
DIANE FRANKOWICH  
MACKINAC COUNTY REGISTER OF DEEDS

OCT 28 1993  
AM \_\_\_\_\_ PM  
7|8|9|10|11|12|1|2|3|4|5|6

Register of Deeds Stamp & File Number

A	B	C	D	E	F	G	H	I	J	K	L	M
2	6	5	4	3	2	1						
3		●										
4	7	8	9	10	11	12						
5												
6	18	17	16	15	14	13						
7												
8	19	20	21	22	23	24						
9												
10	30	29	28	27	26	25						
11												
12	31	32	33	34	35	36						
13												

I, David B. Guthrie, in a field survey on June 2, 1993, do hereby certify that under requirements of P.A. 74, Michigan P.A. of 1970, the corner points mentioned in lines 1 and 2 above were in conformance with regulations and rules therefore as required in the current manual of survey instructions of the United States Department of the Interior, Bureau of Land Management or by a decree of a Court of Law and/or that the corner points mentioned in lines 3, 4 and 5 above were in conformance with the rules of the Michigan Board of Land Surveyors or by a Decree of a Court of Law; established, re-established, monumented, re-monumented, recovered, found as expressed below:


NOTE: Not more than 4 corners, all in the same town and range, may be recorded on this certificate.

A. Description of original monument and accessories and/or subsequent restoration:  
 1845: Established by J.H. Mullett, G.L.O. Survey. A 6" Birch was used as this corner. No references were established.  
 1987: Survey by Richard L. Hays of Nordlund & Assoc. for U.S. Forest Service.  
 - 1989

B. Description of corner evidence found and/or method applied in restoring or reestablishing corner:  
 1993: Found a 2½" x 3' aluminum monument with a 3" aluminum cap stamped to identify the corner. This corner was set in 1989 by Richard L. Hays, P.S. No. 25847 to replace a 4" spike. The corner was recorded November 3, 1989. (Book D, page 52)  
 Plat of Survey Recorded as U.S. Gov't. Plat of Survey No. 14.

C. Description of monument for corner and accessories established to perpetuate locating the position of the corner:  
 1993: N82°W - 63.30 feet - 13" Spruce  
 S54°W - 85.67 feet - 6" Spruce  
 S19°E - 90.58 feet - 15" White Pine  
 S57°E - 45.18 feet - 7" Birch  
 N88°E - 20.00 feet - 2½" x 3' aluminum monument  
 East - 21.20 feet - Cedar Post

(Tree references are blazed and tagged)  
The monument is a 2½"x3' aluminum monument with a 3" aluminum cap stamped to identify the corner.

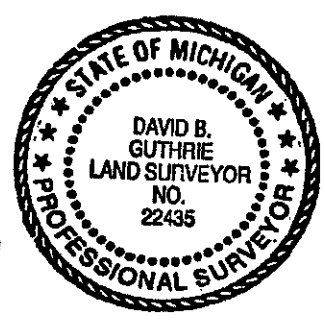

Signed by D.B. Guthrie Date Sept. 27, 1993  
Surveyor's Michigan License No. 22435