SURVEY & REMONUMENTATION

1993

COMMISSION

1993 Mackinac County Remonumentation Corner

LAND CORNER RECORDATION CERTIFICATE

Filing Requirement of Act 74, Mich. P.A. 1970

For corners in Mackinac (County)

	Located In:	Corner Code #
1. Public Land Survey	T 43N R 2W	E-2
	T ___ R ___	
	T ___ R ___	
	T ___ R ___	
2. Property Controlling	S ___ T ___ R ___	
in Section	S ___ T ___ R ___	
3. Miscellaneous	S ___ T ___ R ___	
Property in Sec.	S ___ T ___ R ___	

RECEIVED & FILED
DIANE FRAZ MOVICH
MACKINAC COUNTY REGISTER OF DEEDS

OCT 28 1993

AM PM

7 8 9 10 11 12 1 2 3 4 5 6

Register of Deeds Stamp & File Number

4. Lot No. _____ , Recorded Plat _____
5. Private Claims _____

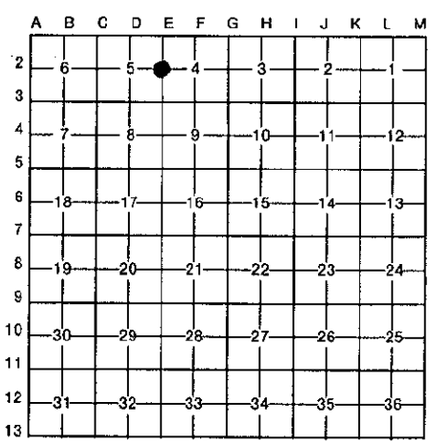

I, David B. Guthrie, in a field survey on June 8, 1993, do hereby certify that under requirements of P.A. 74, Michigan P.A. of 1970, the corner points mentioned in lines 1 and 2 above were in conformance with regulations and rules therefore as required in the current manual of survey instructions of the United States Department of the Interior, Bureau of Land Management or by a decree of a Court of Law and/or that the corner points mentioned in lines 3, 4 and 5 above were in conformance with the rules of the Michigan Board of Land Surveyors or by a Decree of a Court of Law; established, re-established, monumented, re-monumented, recovered, found as expressed below:

NOTE: Not more than 4 corners, all in the same town and range, may be recorded on this certificate.

A. Description of original monument and accessories and/or subsequent restoration:

1845: Established by J.H. Mullett, G.L.O. Survey
A 10" Spruce was established as the corner.
No references were established.

1987: Survey by Richard L. Hays of Nordlund & Assoc. for U.S. Forest Service.
- 1989

B. Description of corner evidence found and/or method applied in restoring or reestablishing corner:

1993: Found a 2½" x 3' aluminum monument with a 3" aluminum cap stamped to identify the corner. Set in 1989 by Richard L. Hays P.S. No. 25847 by single proportionate measurement between the Northeast and Southeast corners of Section 5. Recorded January 3, 1990. (Book D, page 33)

Plat of Survey Recorded U.S. Gov't. Plat of Survey No. 14.

C. Description of monument for corner and accessories established to perpetuate locating the position of the corner:

1993: N46°E - 58.07 feet -(R= 58.10') - 12" Maple
N43°W - 75.78 feet - (R=75.82') - 7" Aspen
S58°W - 5.82 feet - 4" Wild Cherry
S27°W - 34.99 feet - - 4" Birch
North - 2.00 feet - Cedar Post

(Tree references are blazed and tagged.)
The monument is a 2½"x3' aluminum monument with a 3" aluminum cap stamped to identify the corner.

STATE OF MICHIGAN
DAVID B. GUTHRIE
LAND SURVEYOR
NO. 22435
PROFESSIONAL SURVEYOR

Signed by D. B. Guthrie Date Sept. 27, 1993

Surveyor's Michigan License No. 22435

FORM APPROVED BY MICHIGAN STATE BOARD OF LAND SURVEYORS, JAN. 28, 1971
REVISED MAY 14, 1975
REVISED JAN., 1983

D-0202