1993 Mackinac County Remonumentation Corner

1993

COMMISSION

LAND CORNER RECORDATION CERTIFICATE

Filing Requirement of Act 74, Mich. P.A. 1970

For corners in Mackinac (County)

	Located In:	Corner Code ##
1. Public Land Survey	T 43N R 2W	F-3
	T ___ R ___	
	T ___ R ___	
	T ___ R ___	
2. Property Controlling	S ___ T ___ R ___	
in Section	S ___ T ___ R ___	
3. Miscellaneous	S ___ T ___ R ___	
Property in Sec.	S ___ T ___ R ___	

RECEIVED & FILED
DIANE FEAR REGISTER
MACKINAC COUNTY REGISTER OF DEEDS

OCT 28 1995

AM PM

7|8|9|10|11|12|1|2|3|4|5|6

Register of Deeds Stamp & File Number

4. Lot No. _____, Recorded Plat _____
5. Private Claims _____

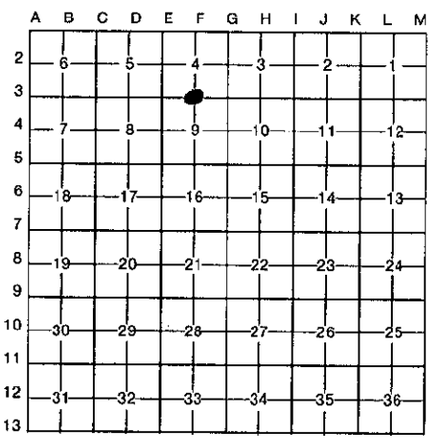

I, David B. Guthrie, in a field survey on June 8, 19 93, do hereby certify that under requirements of P.A. 74, Michigan P.A. of 1970, the corner points mentioned in lines 1 and 2 above were in conformance with regulations and rules therefore as required in the current manual of survey instructions of the United States Department of the Interior, Bureau of Land Management or by a decree of a Court of Law and/or that the corner points mentioned in lines 3, 4 and 5 above were in conformance with the rules of the Michigan Board of Land Surveyors or by a Decree of a Court of Law; established, re-established, monumented, re-monumented, recovered, found as expressed below:

NOTE: Not more than 4 corners, all in the same town and range, may be recorded on this certificate.

A. Description of original monument and accessories and/or subsequent restoration:

1845: Established by J.H. Mullett, G.L.O. Survey
Set a wood post and referenced: 20" Beech-N15°E-22 Links/6"Beech-S15°W-31Lks
1972: Survey by C. Eugene Ostling. Set ½" iron bar and referenced.
1987: Survey by Richard L. Hays of Nordlund & Assoc. for U.S. Forest Service.
1989

NOTE - Corner set by Ostling in 1972 was not accepted by Hays and U.S. Forest Service.

B. Description of corner evidence found and/or method applied in restoring or reestablishing corner:

1993: Found a 2½" x 3' aluminum monument with a 3" aluminum cap stamped to identify the corner. This corner was set in 1989 by Richard L. Hays, P.S. No. 25847, by single proportionate measurement between the Northwest and the Northeast corners of Section 9. The corner was recorded November 27, 1989. (Book D, page 45)
Plat of Survey Recorded as U.S. Gov't. Plat of Survey No. 14.

C. Description of monument for corner and accessories established to perpetuate locating the position of the corner:

1993: N29°W - 37.60 feet (R= 31.57!) - 8" Maple
S69°W - 7.55 feet - 8" Maple
S25°E - 22.83 feet - 7" Maple
N59°E - 22.60 feet - 8" Maple
North - 2.40 feet - Steel Post

(Tree references are blazed and tagged)

The monument is a 2½"x3' aluminum monument with a 3" aluminum cap stamped to identify the corner.

STATE OF MICHIGAN
DAVID B. GUTHRIE
LAND SURVEYOR
NO. 22435
PROFESSIONAL SURVEYOR

Signed by D. B. Guthrie Date Sept. 27, 1993

Surveyor's Michigan License No. 22435

FORM APPROVED BY MICHIGAN STATE BOARD OF LAND SURVEYORS, JAN. 28, 1971
REVISED MAY 14, 1975
REVISED JAN., 1983

D-0204