1993 Mackinac County Remonumentation Corner

LAND CORNER RECORDATION CERTIFICATE

Filing Requirement of Act 74, Mich. P.A. 1970

1993 COMMISSION

For corners in Mackinac (County)

	Located In:	Corner Code ##
1. Public Land Survey	T 43N R 2W	G-2
	T ___ R ___	
	T ___ R ___	
	T ___ R ___	
2. Property Controlling	S ___ T ___ R ___	
in Section	S ___ T ___ R ___	
3. Miscellaneous	S ___ T ___ R ___	
Property in Sec.	S ___ T ___ R ___	

RECEIVED & FILED
DIANE FRANKSON
MACKINAC COUNTY REGISTER OF DEEDS
OCT 28 1993
AM PM
7 8 9 10 11 12 1 2 3 4 5 6

Register of Deeds Stamp & File Number

4. Lot No. _____, Recorded Plat _____
5. Private Claims _____

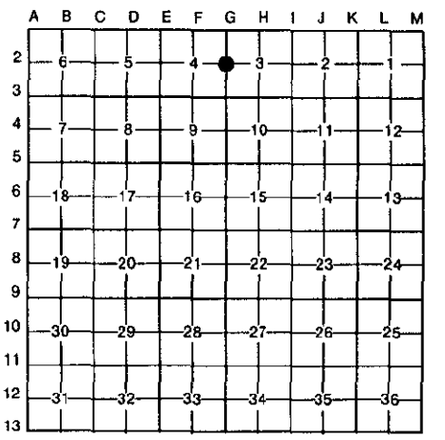

I, David B. Guthrie, in a field survey on June 8, 19 93, do hereby certify that under requirements of P.A. 74, Michigan P.A. of 1970, the corner points mentioned in lines 1 and 2 above were in conformance with regulations and rules therefore as required in the current manual of survey instructions of the United States Department of the Interior, Bureau of Land Management or by a decree of a Court of Law and/or that the corner points mentioned in lines 3, 4 and 5 above were in conformance with the rules of the Michigan Board of Land Surveyors or by a Decree of a Court of Law; established, re-established, monumented, re-monumented, recovered, found as expressed below:

NOTE: Not more than 4 corners, all in the same town and range, may be recorded on this certificate.

A. Description of original monument and accessories and/or subsequent restoration:

1845: Established by J.H. Mullett, G.L.O. Survey. Set wood post and referenced: 10" Sugar Maple - S81°E - 24 Links / 20" Sugar Maple - N59°W - 12 Links
1971: Survey by Mary C. Feindt.

1987: Survey by Richard L. Hays of Nordlund & Assoc. for U.S. Forest Service.
- 1989 -

B. Description of corner evidence found and/or method applied in restoring or reestablishing corner:

1993: Found 2½" x 3' aluminum monument with a 3" aluminum cap stamped to identify the corner. Set in 1987 by Richard L. Hays to replace a previously set "T" iron by Mary Feindt. 1987 corner by Richard L. Hays P.S. No. 25847 recorded December 9, 1988. (Book G, page 347)
Plat of Survey Recorded as U.S. Gov't. Plat of Survey No. 14.

C. Description of monument for corner and accessories established to perpetuate locating the position of the corner:

1993: N27°W - 22.40 feet (R= 22.35') - 6" Birch
S84°E - 58.48 feet - 10 " Cedar
S87°E - 7.64 feet (R= 7.62') - 6' Birch
S71°W - 20.21 feet (R= 20.28') - 8" Cedar
S49°E - 12.38 feet - 8" Birch
North - 3.00 feet - (R=2.80') - Cedar Post
The monument is a 2½"x3' aluminum monument with a 3" aluminum cap stamped to identify the corner.
(Tree references are blazed and tagged.)

STATE OF MICHIGAN
DAVID B. GUTHRIE
LAND SURVEYOR
NO. 22435
PROFESSIONAL SURVEYOR

Signed by D.B. Guthrie Date 9/27/93

Surveyor's Michigan License No. 22435

FORM APPROVED BY MICHIGAN STATE BOARD OF LAND SURVEYORS, JAN. 28, 1971
REVISED MAY 14, 1975
REVISED JAN., 1983

D-0199