

SURVEY & REMONUMENTATION

JAN 21 1999

LAND CORNER RECORDATION CERTIFICATE
Filing Requirement of Act 74, Mich. P.A. 1970
Mackinac County Remonumentation Corner

SECTION

For corners in

Mackinac County	Located in:	Corner Code #
1. Public Land Survey	T43N R2W T44N R2W	I-1 I-13 (Same corner Chippewa County)
	T R	
	T R	
2. Property Controlling in Section	S T R	
	S T R	
3. Miscellaneous Property in Sec.	S T R	
	S T R	
4. Lot No.	, Recorded Plat	
5. Private Claims		

RECEIVED & FILED
DIANE FRANKOVICH
 MACKINAC COUNTY REGISTRE OF DEEDS

DEC 30 1998
 AM PM
 7|8|9|10|11|12|1|2|3|4|5|6

Register of Deeds Stamp & File Number

I, Keith R. Waters, in a field survey on October 30, 1998, do hereby state that under requirements of P.A. 74, Michigan P.A. of 1970, the corner points mentioned in lines 1 and 2 above were in conformance with regulations and rules therefore as required in the current manual of survey instructions of the United States Department of the Interior, Bureau of Land Management or by a decree of a Court of Law and /or that the corner points mentioned in lines 3, 4 and 5 above were in conformance with the rules of the Michigan Board of Land Surveyors or by a Decree of a Court of Law; established, re-established, monumented, recovered, found as expressed below:


NOTE: Not more than 2 corners, all in the same town and range, may be recorded on this certificate.

A. Description of original monument and accessories and/or subsequent restoration:

I-1 Cor. Common to Secs. 2 & 3, T43N, R2W & Secs. 34 & 35, T44N, R2W

- 1840 - Original corner established by William A. Burt. Witnesses: Cedar 14, N37°E 16 links - Cedar 14, N84°W 10 lks.
- 1845 - Witnesses added by James Mullett during the subdivision of Town 43 North, Range 2 West:
Cedar 18, S19°E 06 links - Birch 10, S56°W 37 links.
- 1971 - LCRC, liber A-73, Mackinac County corner records (recorded in 1973). Mary C. Feindt, P.S. 3920, found 1½" iron pipe. Witnesses: 6" Spruce, S13°E 48.7' - 3" Spruce, N80°W 41' - 5" White Birch, N13°E 122.5'.
- 1972 - LCRC, liber A-41, Mackinac County corner records (recorded in 1972). C. Eugene Ostling, P.S. 12026, Found 1½" pipe. Witnesses: Fence post, N88°14'W 32.65' - 10" Spruce, S07°20'E 49.4' - 10" Spruce, S70°05'E 76.6'.
- 1995 - LCRC, liber 9, page 246, Chippewa County corner records. Keith R. Waters, P.S. 33142, corner being perpetuated as part of the Chippewa County Remonumentation Program. Found a 1½" i.d. iron pipe as called for in Mackinac County LCRC's. Witnesses:
 Nail and tag #33142 in side of 12" Tamarack, S68°W 116.68'
 Nail and tag #33142 in side of 8" Balsam Fir, S02°E 40.90'
 Nail and tag #33142 in side of 12" Spruce, S69°E 96.40'
 Nail and tag in side of Power Pole (PD4/151A/16A), N34°W 62.00'
 5/8" Rebar with cap #21566 #25834, SOUTH 33.04'
 1¼" Iron Bar, WEST 32.95'

ACCEPTED BY THE MACKINAC COUNTY
 SURVEY PEER GROUP AS THE
 OFFICIAL CORNER UNDER PA.
 345 OF 1990 AT A MEETING
 HELD ON 11-20-98 NEH

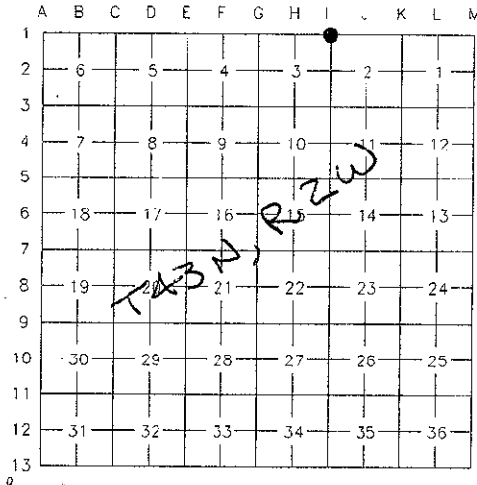

B. Description of corner evidence found and/or method applied in restoring or reestablishing corner:

This corner is being perpetuated as part of the Mackinac County Remonumentation Program. Found the 1½" iron pipe and all record witness objects as called for in 1995 Chippewa County LCRC.

C. Description of monument for corner and accessories established to perpetuate locating the position of the corner:

- Found a 1½" i.d. iron pipe at the corner location, which falls at the approximate centerline P.I. of gravel roads north (Jarvie Road) and east (Townline Road). Witnesses:
 Nail and tag #33142 in side of 12" Tamarack, S68°W 116.68' (with metal bearing tree sign)
 Nail and tag #33142 in side of 8" Balsam Fir, S02°E 40.90' (with metal bearing tree sign)
 Nail and tag #33142 in side of 12" Spruce, S69°E 96.40' (with metal bearing tree sign)
 Nail and tag #33142 in side of Power Pole (PD4/151A/16A), N34°W 62.00'
 5/8" Rebar with cap #21566 #25834, SOUTH 33.04'
 5/8" Rebar with cap #21566 #25834, WEST 32.95'



Signed by Keith R. Waters

Date 12-23-98

Surveyor's Michigan License No. 33142