

**JAN 21 1999**

**LAND CORNER RECORDATION CERTIFICATE**  
**Filing Requirement of Act 74, Mich. P.A. 1970**  
**Mackinac County Remonumentation Corner**

**SECTION**

For corners in


Mackinac County	Located in:	Corner Code #
1. Public Land Survey	T43N R2W T44N R2W	<b>K-1</b> K-13 (Same corner Chippewa County)
	T R T R T R T R	
2. Property Controlling in Section	S T R S T R	
3. Miscellaneous Property in Sec.	S T R S T R	
4. Lot No. , Recorded Plat		
5. Private Claims		

**RECEIVED & FILED**  
**DIANE FRANKOVICH**  
 MACKINAC COUNTY REGISTER OF DEEDS

**DEC 30 1998**  
 AM PM  
 7|8|9|10|11|12|1|2|3|4|5|6

Register of Deeds Stamp & File Number

ACCEPTED BY THE MACKINAC COUNTY  
 SURVEY PEER GROUP AS THE  
 OFFICIAL CORNER UNDER P.A.  
 345 OF 1990 AT A MEETING  
 HELD ON 11-20-98 NEH

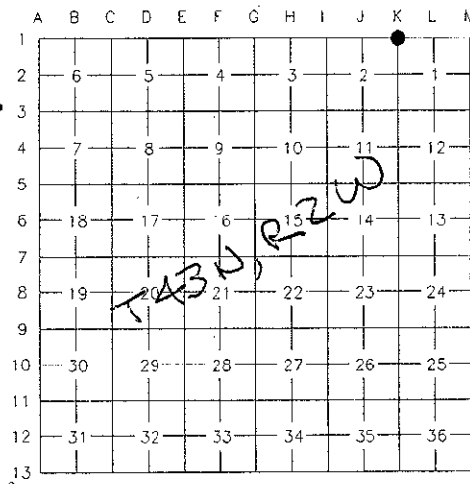

I, Keith R. Waters, in a field survey on October 30, 1998, do hereby state that under requirements of P.A. 74, Michigan P.A. of 1970, the corner points mentioned in lines 1 and 2 above were in conformance with regulations and rules therefore as required in the current manual of survey instructions of the United States Department of the Interior, Bureau of Land Management or by a decree of a Court of Law and /or that the corner points mentioned in lines 3, 4 and 5 above were in conformance with the rules of the Michigan Board of Land Surveyors or by a Decree of a Court of Law; established, re-established, monumented, recovered, found as expressed below:

NOTE: Not more than 2 corners, all in the same town and range, may be recorded on this certificate.

A. Description of original monument and accessories and/or subsequent restoration:

K-1 Cor. Common to Secs. 1 & 2, T43N, R2W & Secs. 35 & 36, T44N, R2W

- 1840 - Original corner established by William A. Burt. Witnesses: Black Ash 9, N12°W 36 links - Fir 9, N42°E 21 links.
- 1845 - Witnesses added by James Mullett during the subdivision of Town 43 North, Range 2 West: Spruce 16, S37°W 25 links - Cedar 20, S21°E 45 links.
- 1924 - Chippewa County Surveyor notes indicate a monument and oak stake placed in hole of original post 79 years old. Witnesses: Spruce 6, S38°E 50.5' - Small monument, N65°E 46' - Fence corner, Northeast 31.5' - Fence corner, Northwest 30' - Range of east-west fence, North 27'.
- 1972 - LCRC, liber A-39, Mackinac County corner records. C. Eugene Ostling, P.S. 12026, found a 1/2" pipe. Witnesses: Fence post, S53°25'W 47.15' - Fence post, N33°01'E 32.75' - 10" Birch, S29°27'E 40.2'
- 1995 - LCRC, liber 9, page 248, Chippewa County corner records. Keith R. Waters, P.S. 33142, corner being perpetuated as part of the Chippewa County Remonumentation Program. Found and accepted a 1/2" iron pipe as described in Mackinac County LCRC. The position checks with witnesses from both 1924 and 1972 records. The distance to a section corner 2 miles north is also with 1 foot of that as shown in 1917 Chippewa County Surveyor notes. Note that a 1 1/2" pipe was found bearing N32°E 17.6 feet from the accepted corner location, and that both of these found pipes appear to be in conflict with a position as shown in a Certificate of Survey as recorded in liber 1, pages 415-417, Mackinac County records. Replaced the found 1/2" pipe with a 3/4" rebar with a plastic Chippewa County Remonumentation cap. Witnesses:  
 Nail and tag #33142 in side of clump of 2"-4" Willows, S60°W 102.94'  
 Nail and tag #33142 in side of 14" Spruce, S16°E 73.26'  
 Nail and tag #33142 in side of Power Pole (PD4/121/42), S46°E 46.32'  
 Nail and tag #33142 in side of Power Pole, S83°W 287.29'



B. Description of corner evidence found and/or method applied in restoring or reestablishing corner:

This corner is being perpetuated as part of the Mackinac County Remonumentation Program. Found the 3/4" rebar w/cap and all witnesses all called for in the above mentioned Chippewa County LCRC.

C. Description of monument for corner and accessories established to perpetuate locating the position of the corner:

- Found a 3/4" rebar with plastic Chippewa County Remonumentation cap at the corner location, which falls at the approximate centerline intersection of Townline and Steinback roads. Witnesses:  
 Nail and tag #33142 in side of clump of 2"-4" Willows, S60°W 102.94' (Face and side blazed)  
 Nail and tag #33142 in side of 14" Spruce, S16°E 73.26' (Side blazed only)  
 Nail and tag #33142 in side of Power Pole (PD4/121/42), S46°E 46.32'  
 Nail and tag #33142 in Power Pole (RU2/24/C1/1), S83°W 287.29'

Signed by Keith R. Waters Date 12-23-98

Surveyor's Michigan License No. 33142