

MICHIGAN
DEPARTMENT OF CONSERVATION
FORESTRY DIVISION

LAND CORNER RECORD

T. 44 N.R. 7W


Mackinac COUNTY

DESCRIPTION OF CORNER Sec. Cor. for Sections 34 and 35 on South boundary of township.

CORNER MONUMENT 1" Pipe with 4" Aluminum Cap.

DATE MONUMENT PLACED AND WITNESSED 3-29-63

WITNESSES TO CORNER..... No witnesses available.

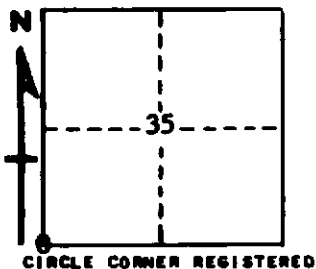

CIRCLE CORNER REGISTERED

AND

DESCRIPTION IN DETAIL AS TO HOW CORNER WAS LOCATED AND IDENTIFIED OR RESTORED.

This Corner replaced at post set by Marcus Schaaf, Registered Land Surveyor, Found one Tamarack stump bottom in proper position. Cor. lies in open spruce swamp.

Note: Closing Corner for Sections 2 and 3, T43N R7W, lies 28 Links West of this corner.

SURVEYOR'S SEAL

SIGNED *Billy D. Buckler* DATE 10/11/83
REGISTERED LAND SURVEYOR