

CORNERS ARE  
MARKED BY IRON  
PIPE IN A 3" DRILL  
HOLE, IN LIMESTONE.

SEC. COR. 33/34  
T44N R7W


CLOSING COR.

TWP LINE

4/3, T43N R7W

N 0° 01' 40" E, 2603.6'

CAFFEY  
CEMETERY

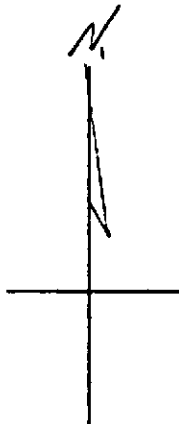

BDB  
9/28/76

