

LAND CORNER RECORDATION CERTIFICATE

FILING REQUIREMENT OF ACT 74, MICH. P.A. 1970
 Mackinac County 4 corners

FOR CORNERS OF--	LOCATED IN--	CORNER CODE NUMBER
1. PUBLIC LAND SURVEY _____	T. <u>44</u> N. <u>7</u> E. <u>W.</u>	<u>L-9, I-11, K-11, G-11</u>
2. PROPERTY CONTROLLING IN SECTION _____	T. _____ N. _____ E. _____ S. _____ R. _____ W. _____	_____
3. MISCELLANEOUS PROPERTY IN SECTION _____	T. _____ N. _____ E. _____ S. _____ R. _____ W. _____	_____
4. LOT NO. _____, RECORDED PLAT _____		
5. PRIVATE CLAIMS _____		

REGISTER OF DEEDS STAMP AND FILING NUMBER

I, Billy D. Buckler, do hereby certify that under requirements of P.A. 74, Michigan P.A. of 1970, the corner points mentioned in lines 1 and 2 above were, in a field survey on 9-28, 10-9, 1979, established, re-established, monumented, re-monumented, recovered or restored as expressed below and in conformance with regulations and rules therefore as required in the current manual of survey instructions of the United States Department of the Interior, Bureau of Land Management or by a decree of a court of law. Furthermore, that the corner points mentioned in lines 3, 4 and 5 above were, in a field survey on _____, 19____, found, recovered, restored, established or re-established as expressed below and in conformance with the rules of the Michigan State Board of Registration for Land Surveyors or, by a Decree of a Court of law:

A. Description of original monument and accessories and/or subsequent restoration:

- Sec. Cor. and 1/4 cors. set by H. Brevort Jr., D.S. in 1845. Bearings were:**
- L-9 1/4 Cor. bet. Sec's. 24-25: Tam 4, S73°W, 10 lks. & tam 12, S75°E, 06 lks.
 - I-11 Sec. Cor. 26-27-34-35: Tam 6, N45°W, 31 lks. - spruce 4, N56°E, 30 lks.
 - K-11 Sec. Cor. 25-26-35-36: spruce 3, S47°W, 16 lks-spruce 4, N49°E, 16 lks.
 - G-11, Sec. Cor. 27-28-33-34.


B. Description of corner evidence found and/or method applied in restoring or re-establishing corner:

- L-9 Restored corner midway and on line bet. two Sec. Cors.
- I-11 Restored corner by D.P.M. from corners in all four directions.
- K-11 Restored corner by D.P.M. bet. Cors in all four directions.
- G-11 Restored corner by D.P.M. bet corners in all four directions.

C. Description of monument for corner and accessories established to perpetuate locating the position of the corner:

- L-9 Placed 1" pipe w/4" alum cap, at corner. New bearings: 7" tam, S31°W, 24.2' 8" cedar, N5°W, 10.3'-6" cedar, S76°E, 13.7'
- I-11 Placed 1" pipe w/4" alum. cap, at corner. New bearings: 10" w.birch, N29°W, 15.1'-6" spruce, N75°W, 4.0'. Corner lies in north edge of open marsh and 187' south of R.R. track.
- K-11 Placed 1" pipe w/4" aluminum cap at corner. New bearings: 6" tam. S64°W, 45.8' - 6" tam. N57°E, 20.4', corner lies in spruce bog, 150' south of small ridge.
- G-11 Placed 1" pipe w/4" alum. cap at corner. New bearings: 3" spruce, S74°E, 5.2' - 4" spruce, south 43.6'. Corner lies in an open spruce bog.

SIGNED BY _____ DATE 3-18-80
Billy D. Buckler
 SURVEYOR'S MICHIGAN REGISTRATION NO. 8887

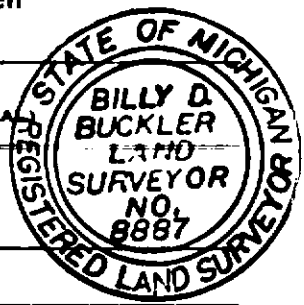

FOR STATE AND UNITED STATES AGENCIES:

SIGNED BY _____ DATE _____
CHIEF OF SURVEY PARTY
 APPROVED AND SIGNED BY _____ DATE _____
MICHIGAN REGISTERED LAND SURVEYOR

SURVEYOR'S MICHIGAN REGISTRATION NO. _____