

**LAND CORNER RECORDATION CERTIFICATE**  
**Filing Requirement of Act 74, Mich. P.A. 1970**

For corners in  
Mackinac  
 (County)

Located In: \_\_\_\_\_ Corner Code # \_\_\_\_\_

- |                                    |                          |           |
|------------------------------------|--------------------------|-----------|
| 1. Public Land Survey              | T <u>44N</u> R <u>7W</u> | <u>16</u> |
|                                    | T _____ R _____          | _____     |
|                                    | T _____ R _____          | _____     |
|                                    | T _____ R _____          | _____     |
| 2. Property Controlling in Section | S _____ T _____ R _____  | _____     |
|                                    | S _____ T _____ R _____  | _____     |
| 3. Miscellaneous Property in Sec.  | S _____ T _____ R _____  | _____     |
|                                    | S _____ T _____ R _____  | _____     |

Register of Deeds Stamp & File Number

4. Lot No. \_\_\_\_\_, Recorded Plat \_\_\_\_\_  
 5. Private Claims \_\_\_\_\_

Aug 05 2002

I, Stephan J. Szyszkoski, in a field survey on \_\_\_\_\_, 19\_\_\_\_ do hereby state that under requirements of P.A. 74, Michigan P.A. of 1970, the corner points mentioned in lines 1 and 2 above were in conformance with regulations and rules therefore as required in the current manual of survey instructions of the United States Department of the Interior, Bureau of Land Management or by a decree of a Court of Law and /or that the corner points mentioned in lines 3, 4 and 5 above were in conformance with the rules of the Michigan Board of Land Surveyors or by a Decree of a Court of Law, established, re-established, monumented, recovered, found as expressed below:

NOTE: Not more than 2 corners, all in the same town and range, may be recorded on this certificate.

A	B	C	D	E	F	G	H	I	J	K	L	M
1												
2	6	5	4	3	2	1						
3												
4	7	8	9	10	11	12						
5												
6	18	17	16	15	14	13						
7												
8	19	20	21	22	23	24						
9												
10	30	29	28	27	26	25						
11												
12	31	32	33	34	35	36						
13												


A. Description of original monument and accessories and/or subsequent restoration:  
 (16) Quarter corner common to Sections 14-15. 1845: Established by H. Breevort, Jr.: North between 14 & 15 ...40.00 Set quarter section post. Maple 12 S77E 12, Maple 12 S77W 31..80.00 Set post corner Sections 10,11,14,15. 1854: Examination by Geo. H. Cannon: North between 14-15 chained...40.15 qr. Section corner post. Maple 11 S78E 10.5, Maple 11 S75W 27...79.94 Corner of sects 10,11,14,15. Found no subsequent record.

B. Description of corner evidence found and/or method applied in restoring or reestablishing corner:

(16) The original post and accessories were not recovered. Reestablished the corner midway an on a line of mean true bearing between Section corners of record 2605.20' north and south, being in proportion to the original measure. I did not prorate to the examiner's measure because it appears that his measure was, in this township, no more reliable than the original surveyor's. Billy D. Buckler RLS, in reestablishing other nearby corners in this township also rejected the examiner's measure in favor of Mr. Breevort's. From the corner monumented, the center of a trail road is 23' north.

C. Description of monument for corner and accessories established to perpetuate locating the position of the corner:

(16) Set 1"IDx36" I.pipe with 4" alum. MDNR cap. Blazed, scribed, and set measuring nails in:  
 5" Spruce S16W 33.2' "1/4S NBT"  
 4" Spruce S08E 29.5' do  
 5" Maple S46E 28.5' do  
 5" Balsam N78E 20.5' do  
 Placed cedar post adjacent. Bearings are magnetic. Distances are to nail with tag.

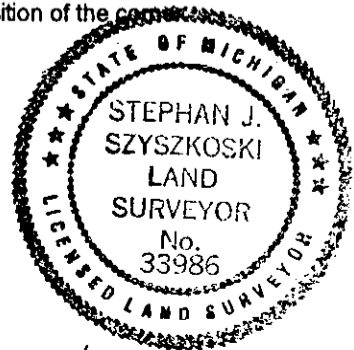

Signed by Stephan J. Szyszkoski  
 Surveyor's Michigan License No. 33986

Date 8/7/02