

**LAND CORNER RECORDATION CERTIFICATE**  
**Filing Requirement of Act 74, Mich. P.A. 1970**

For corners in  
Mackinac

(County)

Located In:

Corner Code #

1. Public Land Survey	T <u>44</u> N R <u>7</u> W	<u>H5</u>
	T ___ R ___	_____
	T ___ R ___	_____
	T ___ R ___	_____
2. Property Controlling in Section	S <u>15</u> T <u>44</u> N R <u>7</u> W	<u>2</u>
	S ___ T ___ R ___	_____
3. Miscellaneous Property in Sec.	S ___ T ___ R ___	_____
	S ___ T ___ R ___	_____

Register of Deeds Stamp & File Number

4. Lot No. \_\_\_\_\_, Recorded Plat \_\_\_\_\_  
 5. Private Claims \_\_\_\_\_

Jul 15 2002

I, Stephan J. Szyszkoski, in a field survey on \_\_\_\_\_, 19\_\_\_\_ do hereby state that under requirements of P.A. 74, Michigan P.A. of 1970, the corner points mentioned in lines 1 and 2 above were in conformance with regulations and rules therefore as required in the current manual of survey instructions of the United States Department of the Interior, Bureau of Land Management or by a decree of a Court of Law and/or that the corner points mentioned in lines 3, 4 and 5 above were in conformance with the rules of the Michigan Board of Land Surveyors or by a Decree of a Court of Law, established, re-established, monumented, recovered, found as expressed below:


NOTE: Not more than 2 corners, all in the same town and range, may be recorded on this certificate.

A	B	C	D	E	F	G	H	I	J	K	L	M
1												
2	6	5	4	3	2	1						
3												
4	7	8	9	10	11	12						
5							●					
6	10	17	16	15	14	13						
7												
8	19	20	21	22	23	24						
9												
10	30	29	28	27	26	25						
11												
12	31	32	33	34	35	36						
13												

A. Description of original monument and accessories and/or subsequent restoration:  
 (H5) Quarter corner common to Sections 10-15. 1845: Established by H.Breevort, Jr.: West corrected between sections 10 & 15...40.14 Set quarter section post. Beech 8 S62E 12, Hemlock 10 N39W 10... 80.28 Section corner. Found no subsequent record.  
 (2-Sec. 15) East 1/16 corner between Sections 10-15. Not established in the original survey.

B. Description of corner evidence found and/or method applied in restoring or reestablishing corner:  
 (H5) The original post and accessories were not recovered. Found no evidence of the position of the original corner on the ground. Reestablished the corner midway and on a line of mean true bearing between Section corners of record 2590.45' east and west, the position being in proportion to the original record. The center of a trail road is south 46' from the corner.  
 (2-Sec. 15) Established the corner midway and on a line of mean true bearing between Quarter corner 1295.23' west and Section corner 1295.23' east.

C. Description of monument for corner and accessories established to perpetuate locating the position of the corner:  
 (H5) Set 1"IDx36" I.pipe with 4" alum. MDNR cap. Blazed, scribed, and set measuring nails in:  
 8" W.Pine S40W 3.8'                      "1/4S NBT"  
 3" Balsam S77E 8.65'                    do  
 3" Maple N32E 4.65'                    do  
 5" Balsam S72W 24.1'                   do  
 Bearings are magnetic. Distances are to nail with tag.  
 (2) Set 1"IDx36" I.pipe with 4" alum. MDNR cap. Blazed, scribed, and set measuring nails in:  
 12" Balsam S09W 9.15'                      "E1/16 BT"  
 14" W.Pine S52E 17.35'                    do  
 5" Spruce N04W 3.15'                    do  
 12" Maple S78E 12.65'                    do  
 Placed cedar post adjacent. Bearings are magnetic. Distances are to nail with tag.

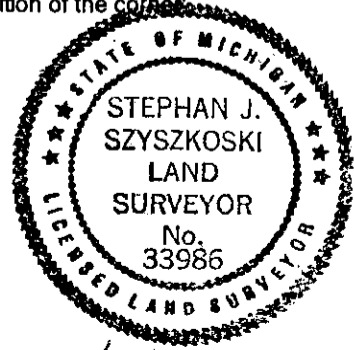

Signed by Stephan J. Szyszkoski Date 8/7/02  
 Surveyor's Michigan License No. 33986