

LAND CORNER RECORDATION CERTIFICATE
Filing Requirement of Act 74, Mich. P.A. 1970 as Amended

For corners in

<u>Mackinac</u> (County)	Located In:	Corner Code #
1. Public Land Survey	T <u>44N</u> R <u>7W</u>	<u>811</u>
	T _____ R _____	_____
	T _____ R _____	_____
2. Property Controlling in Section	S _____ T _____ R _____	_____
	S <u>31</u> T <u>44N</u> R <u>7W</u>	<u>8</u>
	S _____ T _____ R _____	_____
3. Miscellaneous Property in Sec.	S _____ T _____ R _____	_____
	S _____ T _____ R _____	_____

Register of Deeds Stamp & File Number

4. Lot No. _____, Recorded Plat _____
 5. Private Claims

811 Jul 21 2005
 8 Nov 05 2005

I, Stephan J. Szyszkoski, in a field survey on _____, 20____ do hereby state that under requirements of P.A. 74, Michigan P.A. of 1970, the corner points mentioned in lines 1 and 2 above were in conformance with regulations and rules therefore as required in the current manual of survey instructions of the United States Department of the Interior, Bureau of Land Management or by a decree of a Court of Law and /or that the corner points mentioned in lines 3, 4 and 5 above were in conformance with the rules of the Michigan Board of Land Surveyors or by a Decree of a Court of Law; established, re-established, monumented, recovered, found as expressed below:

NOTE: Not more than 2 corners, all in the same town and range, may be recorded on this certificate.

A. Description of original monument and accessories and/or subsequent restoration:

(B11) Quarter corner common to Sections 30 and 31. 1845 - Established by H.Bravoort, Deputy Surveyor: East corrected between Sections 30 & 31 ...39.22 Set 1/4 Sec. post. Birch 10 N58E 24 links, Beech 6 S51W 42 links ...79.22 Section corner.
 (8-Sec. 31) West 1/16 corner, Section 31. Not established in the original survey.

	A	B	C	D	E	F	G	H	I	J	K	L	M
1													
2	6		5		4		3		2		1		
3													
4	7		8		9		10		11		12		
5													
6	10		17		16		15		14		13		
7													
8	19		20		21		22		23		24		
9													
10	30		29		28		27		26		25		
11	●												
12	●	31		32		33		34		35		36	
13													


B. Description of corner evidence found and/or method applied in restoring or reestablishing corner:

(B11) The original post and accessories were not recovered. Reestablished the corner by single proportionate measurement to the original GLO record and on line between Section corners 2656.30' East and 2604.50' West.
 (8-Sec. 31) Established the corner on a straight line between Center of Section 1325.12' East and Quarter corner 1282.72' West, being 20 chains, proportionate to the record given on the official GLO plat, west of the Center of the Section. From the corner monumented, the south edge of Rexton Lake is about 75' north.

C. Description of monument for corner and accessories established to perpetuate locating the position of the corner:

(B11) Set 1"IDx36" I.pipe with plastic cap "MICH DNR PS33986" flush with ground surface in the E. side of a N-S trail.	(8) Set 1"IDx36" I.pipe with 4" alum. MDNR cap. Set measuring nails in:
Set measuring nails in:	7" Tamarack S14E 8.9' mrkd "W1/16 BT"
14" R.Pine N54E 18.75' mrkd "1/4S NBT"	4" B.Spruce N60W 8.4' do
10" Spruce S62E 55.8' do	3" W.Pine N75E 18.75' do
10" R.Pine S36W 57.65' do	6" B.Spruce S87W 34.85' do
10" R.Pine N56W 66.05' do	Bearings are magnetic. Distances are to nail with tag.

Bearings are magnetic. Distances are to nail with tag.

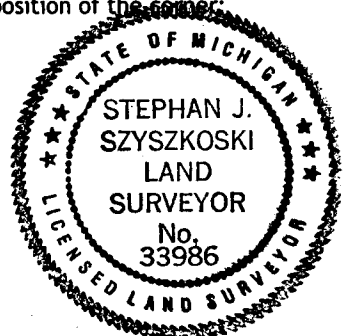

Signed by Stephan J. Szyszkoski
 Surveyor's Michigan License No. 33986

Date 1/26/06