LAND CORNER RECORDATION CERTIFICATE
Filing Requirement of Act 74, Mich. P.A. 1970 as Amended

For corners in

Mackinac (County) Located In: Corner Code #

1. Public Land Survey		T____	R____	
		T____	R____	
		T____	R____	
	S____	T____	R____	
2. Property Controlling	S 32	T 44N	R 7W	16
in Section	S 32	T 44N	R 7W	13
3. Miscellaneous	S____	T____	R____	
Property in Sec.	S____	T____	R____	

Register of Deeds Stamp & File Number

4. Lot No. _____ , Recorded Plat_____

5. Private Claims

13 Jul 20 2005
16 Jul 13 2005

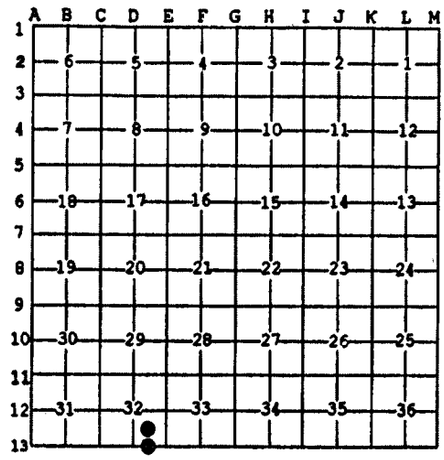

I, Stephan J. Szyszkoski, in a field survey on _____, 20 ____ do hereby state that under requirements of P.A. 74, Michigan P.A. of 1970, the corner points mentioned in lines 1 and 2 above were in conformance with regulations and rules therefore as required in the current manual of survey instructions of the United States Department of the Interior, Bureau of Land Management or by a decree of a Court of Law and /or that the corner points mentioned in lines 3, 4 and 5 above were in conformance with the rules of the Michigan Board of Land Surveyors or by a Decree of a Court of Law; established, re-established, monumented, recovered, found as expressed below:

NOTE: Not more than 2 corners, all in the same town and range, may be recorded on this certificate.

A. Description of original monument and accessories and/or subsequent restoration:

(16-Sec. 32) East 1/16 corner on the south side of Section 32 T44N-R07W (not common with Section 5 T43N-R07W). Established in 1966 by F.J.Bray RLS midway and on line between Section corner to East and 1/4 Corner to West. Set 1" Iron pipe with 4" aluminum cap. Witnesses to corner: 6" Cedar S20E 03 links, 8" W.Pine N25W 37.5 links.
(13-Sec. 32) Southeast 1/16 corner, Section 32. Established in 1981 by Billy D. Buckler RLS: Placed corner at intersection of lines quartering the SE quarter section. Also placed a 5/8" Round Iron, 138.8' West, in line with as [sic] old fence to mark a line of claimed occupation. Placed 3" Square iron 18" long in road at the corner position. Witnesses: 8" Scotch Pine S62E 134.7', 7" Scotch Pine S71W 96.4'. Corner is 3.4' South of road centerline.

B. Description of corner evidence found and/or method applied in restoring or reestablishing corner:

(16-Sec. 32) Recovered the 1966 monument in good condition and at record bearing and distance from the 1966 witnesses. The Cedar SE is a stump, the W.Pine is standing dead. Found the monument to be 0.68' South and 0.20' West of the midpoint position of record and accepted same as a careful and faithful establishment of the position of the corner.
(13-Sec. 32) Found the 1981 monument, as described, in good condition, and at record bearing and distance from the 1981 witness trees. The Scotch Pine SE is in good condition, the Scotch Pine SW is standing dead. Left the monument in place and made new witnesses as described below.

C. Description of monument for corner and accessories established to perpetuate locating the position of this corner:

(16) Found 1"ID I.pipe with 4" alum. MDNR cap. Set measuring nails in:
8" Tamarack N87E 8.0' mrkd "E1/16 BT"
5" Cedar S43E 7.4' do
10" Tamarack S34W 15.95' do
8" Tamarack N79W 13.4' do
Bearings are magnetic. Distances are to nail with tag.

(13) Found 3" Square iron bar 3.4' south of centerline of E-W road. Set measuring nails in:
5" Elm S38W 83.35' mrkd "SE1/16 BT"
6" Scotch Pine N47E 49.3' do
8" Scotch Pine S28E 53.8' do
8" Scotch Pine S54E 77.25' do
Bearings are magnetic. Distances are to nail with tag.

STATE OF MICHIGAN
STEPHAN J. SZYSZKOSKI
LAND SURVEYOR
No. 33986
LICENSED LAND SURVEYOR

Signed by Stephan J. Szyszkoski Date 1/26/06

Surveyor's Michigan License No. 33986

For the Michigan Department of Natural Resources, Office of Land and Facilities

FORM APPROVED BY MICHIGAN STATE BOARD OF PROFESSIONAL SURVEYORS, JAN. 28, 1971
Revised May 14, 1975
Revised Jan., 1983
Revised Oct., 1995