80

LAND CORNER RECORDATION CERTIFICATE

Filing Requirement of Act 74, Mich. P.A. 1970

For corners in
Luce
(County)

	Located In:	Corner Code ##
1. Public Land Survey	T 44N R 8W	L11
	T ___ R ___	
	T ___ R ___	
	T ___ R ___	
2. Property Controlling	S ___ T ___ R ___	
in Section	S ___ T ___ R ___	
3. Miscellaneous	S ___ T ___ R ___	
Property in Sec.	S ___ T ___ R ___	

Register of Deeds Stamp & File Number

4. Lot No. _____ , Recorded Plat _____
5. Private Claims _____

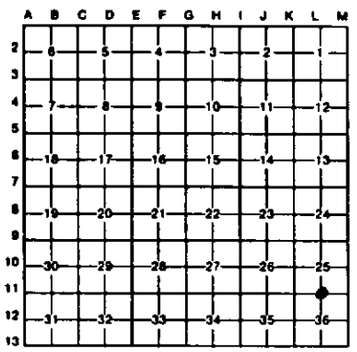

I, Stephan J. Szyszkoski , in a field survey on November 23, 1993 , 19 _____ , do hereby certify that under requirements of P.A. 74, Michigan P.A. of 1970, the corner points mentioned in lines 1 and 2 above were in conformance with regulations and rules therefore as required in the current manual of survey instructions of the United States Department of the Interior, Bureau of Land Management or by a decree of a Court of Law and/or that the corner points mentioned in lines 3, 4 and 5 above were in conformance with the rules of the Michigan Board of Land Surveyors or by a Decree of a Court of Law; established, re-established, monumented, re-monumented, recovered, found as expressed below:

NOTE: Not more than 4 corners, all in the same town and range, may be recorded on this certificate.

A. Description of original monument and accessories and/or subsequent restoration:

(L11) Quarter corner common to Sections 25-36. Corner previously recorded in 1986 by Gerald Wiggins, RLS as follows: "Re-witnessed corner as set by Billy O. Buckler, R.L.S. 3-27-69. DNR monument placed over 1 1/4" pipe. 6" Cedar S44E 5.3', 12" Tamarack N37E 5.6', 10" Tamarack S26W 32.1', 4" Cedar N37W 8.75'".

B. Description of corner evidence found and/or method applied in restoring or reestablishing corner:

(L11) Found the monument described by Wiggins and Buckler at record bearing and distance from Wiggins witnesses. Buried the DNR monument, a 1" ID iron pipe capped with a 4" dia. cast alumium tablet, below the surface of the old grade in which it falls. Marked new witnesses as described below. Revisited the corner location in May, 1995 and noted that both of Wiggin's cedar NBTs have been destroyed. Placed a location post with tag East 10.0' from the monument.

C. Description of monument for corner and accessories established to perpetuate locating the position of the corner:

(L11) 1" pipe with 4" aluminum cap,
buried with 1 1/4" pipe. Blazed,
scribed, and placed measuring nails in
the following:
12" Tamarack N37E 5.6' (1986 witness)
10" Tamarack S26W 32.55'(1986 witness)
6" Cedar S78W 48.6' "1/4S NBT"
3" Tamarack S41W 33.4' "1/4S NBT"
3" Cedar N60W 37.7' "1/4S NBT"
Bearings are magnetic.

STATE OF MICHIGAN
STEPHAN J. SZYSZKOSKI
LAND SURVEYOR
No. 33986
LICENSED LAND SURVEYOR

Signed by Stephan J. Szyszkoski Date 8/29/95

Surveyor's Michigan License No. 33986

FORM APPROVED BY MICHIGAN STATE BOARD OF LAND SURVEYORS, JAN. 28, 1971
REVISED MAY 14, 1975
REVISED JAN., 1983

For the Michigan Department of Natural Resources - Forest Management Division