

SURVEY & REMONUMENTATION

OCT 11 1994

COMMISSION

MACKINAC COUNTY REMONUMENTATION CORNER

LAND CORNER RECORDATION CERTIFICATE

Filing Requirement of Act 74, Mich. P.A. 1970

For corners in

Mackinac (County)	Located In:	Corner Code =#
1. Public Land Survey	T <u>44N</u> R <u>8W</u>	<u>E-7</u>
	T _____ R _____	_____
	T _____ R _____	_____
	T _____ R _____	_____
2. Property Controlling in Section	S _____ T _____ R _____	_____
	S _____ T _____ R _____	_____
3. Miscellaneous Property in Sec.	S _____ T _____ R _____	_____
	S _____ T _____ R _____	_____

RECEIVED & FILED
MACKINAC COUNTY REGISTER OF DEEDS
SEP 6 1994
MACKINAC, MICHIGAN

Register of Deeds Stamp & File Number

4. Lot No. _____, Recorded Plat _____
5. Private Claims _____

	A	B	C	D	E	F	G	H	I	J	K	L	M
2	6	5	4	3	2	1							
3													
4	7	8	9	10	11	12							
5													
6	18	17	16	15	14	13							
7													
8	19	20	21	22	23	24							
9													
10	30	29	28	27	26	25							
11													
12	31	32	33	34	35	36							
13													

I, James H. Granger, in a field survey on August 9, 19 94, do hereby certify that under requirements of P.A. 74, Michigan P.A. of 1970, the corner points mentioned in lines 1 and 2 above were in conformance with regulations and rules therefore as required in the current manual of survey instructions of the United States Department of the Interior, Bureau of Land Management or by a decree of a Court of Law and/or that the corner points mentioned in lines 3, 4 and 5 above were in conformance with the rules of the Michigan Board of Land Surveyors or by a Decree of a Court of Law; established, re-established, monumented, re-monumented, recovered, found as expressed below:

NOTE: Not more than 4 corners, all in the same town and range, may be recorded on this certificate.

A. Description of original monument and accessories and/or subsequent restoration:

1845 original survey corner was 8" balsam
H. Brevoort

1969 DNR set 1/2" bar
Billy Buckler #8887

B. Description of corner evidence found and/or method applied in restoring or reestablishing corner:

found 1/2" bar and 4 witnesses


ACCEPTED BY THE MACKINAC COUNTY SURVEY PEER GROUP AS THE OFFICIAL CORNER UNDER P.A. 345 OF 1990 AT A MEETING HELD ON 8-16-94

James H. Granger

C. Description of monument for corner and accessories established to perpetuate locating the position of the corner:

set 5/8" rerod w/alum cap

4" spruce	S80°W	71.71'	tag #31591
6" cherry	S65°E	40.07'	tag #31591
6" cherry	S73°E	38.97'	tag #31591
6" spruce	N55°E	112.98'	tag #31591

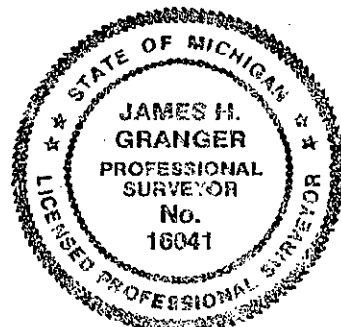

Signed by *James H. Granger*

Date August 30, 1994

Surveyor's Michigan License No. 16041

09-06-94 FORM APPROVED BY MICHIGAN STATE BOARD OF LAND SURVEYORS, JAN. 28, 1971

\$-0298

REVISED MAY 14, 1975
REVISED JAN., 1983