SURVEY &
REMONUMENTATION

OCT 1 1 1994

COMMISSION

MACKINAC COUNTY REMONUMENTATION CORNER

LAND CORNER RECORDATION CERTIFICATE

Filing Requirement of Act 74, Mich. P.A. 1970

For corners in Mackinac (County)

	Located In:	Corner Code ##
1. Public Land Survey	T 44N R 8W	E-8
	T ___ R ___	
	T ___ R ___	
	T ___ R ___	
2. Property Controlling	S ___ T ___ R ___	
in Section	S ___ T ___ R ___	
3. Miscellaneous	S ___ T ___ R ___	
Property In Sec.	S ___ T ___ R ___	

RECEIVED & FILED
[illegible]
SEP 6 1994
AM PM
[illegible]

Register of Deeds Stamp & File Number

4. Lot No. _____ , Recorded Plat _____
5. Private Claims _____

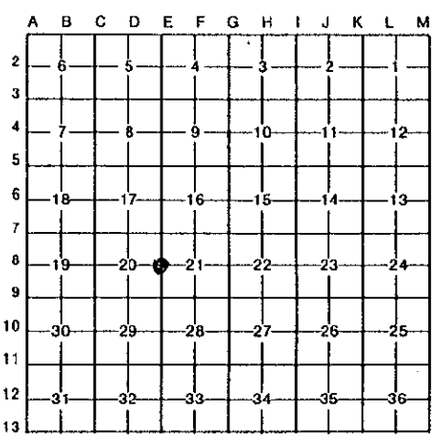

I, James H. Granger, in a field survey on August 4, 19 94, do hereby certify that under requirements of P.A. 74, Michigan P.A. of 1970, the corner points mentioned in lines 1 and 2 above were in conformance with regulations and rules therefore as required in the current manual of survey instructions of the United States Department of the Interior, Bureau of Land Management or by a decree of a Court of Law and/or that the corner points mentioned in lines 3, 4 and 5 above were in conformance with the rules of the Michigan Board of Land Surveyors or by a Decree of a Court of Law; established, re-established, monumented, re-monumented, recovered, found as expressed below:

NOTE: Not more than 4 corners, all in the same town and range, may be recorded on this certificate.

A. Description of original monument and accessories and/or subsequent restoration:

1845 original survey
H. Brevoort

set wood post
3" birch N13°E 28 lks.
3" tamarack S 52°W 9 lks.

1961 DNR
Billy Buckler #8887

set 1" pipe w/brass cap

B. Description of corner evidence found and/or method applied in restoring or reestablishing corner:

found 1" pipe w/brass cap and 4 witnesses

ACCEPTED BY THE MACKINAC COUNTY SURVEY PEER GROUP AS THE OFFICIAL CORNER UNDER P.A. 345 OF 1990 AT A MEETING HELDON 8-16-94
James H Granger

09-06-94

C. Description of monument for corner and accessories established to perpetuate locating the position of the corner:

1" pipe w/brass cap

9" spruce	N 6°E	18.98'	tag #31591
7" maple	N86°E	16.97'	tag #31591
8" maple	S46°E	23.86'	tag #31591
10" birch	N74°W	16.91'	tag #31591

STATE OF MICHIGAN
JAMES H. GRANGER
PROFESSIONAL SURVEYOR
No. 16041
LICENSED PROFESSIONAL SURVEYOR

Signed by James H Granger Date August 30, 1994

Surveyor's Michigan License No. 16041

09-06-94

FORM APPROVED BY MICHIGAN STATE BOARD OF LAND SURVEYORS, JAN. 28, 1971
REVISED MAY 14, 1975
REVISED JAN., 1983

D-0297