

**SURVEY & REMONUMENTATION**

OCT 11 1994

COMMISSION

**MACKINAC COUNTY REMONUMENTATION CORNER**

**LAND CORNER RECORDATION CERTIFICATE**  
**Filing Requirement of Act 74, Mich. P.A. 1970**


For corners in

|  |                          |                |
|--|--------------------------|----------------|
| <u>Mackinac</u><br><small>(County)</small> | Located In:              | Corner Code -# |
| 1. Public Land Survey                      | T <u>44N</u> R <u>8W</u> | <u>E-9</u>     |
|  | T _____ R _____          | _____          |
|  | T _____ R _____          | _____          |
|  | T _____ R _____          | _____          |
| 2. Property Controlling in Section         | S _____ T _____ R _____  | _____          |
|  | S _____ T _____ R _____  | _____          |
| 3. Miscellaneous Property in Sec.          | S _____ T _____ R _____  | _____          |
|  | S _____ T _____ R _____  | _____          |
| 4. Lot No. _____, Recorded Plat _____      |                          |                |
| 5. Private Claims _____                    |                          |                |

RECEIVED & FILED  
 JAMES H. GRANGER  
 MACKINAC COUNTY REGISTER OF DEEDS

SEP 6 1994  
 AM 8:11 PM  
 7/8/9/10/11/12/13/14/15/16

Register of Deeds Stamp & File Number

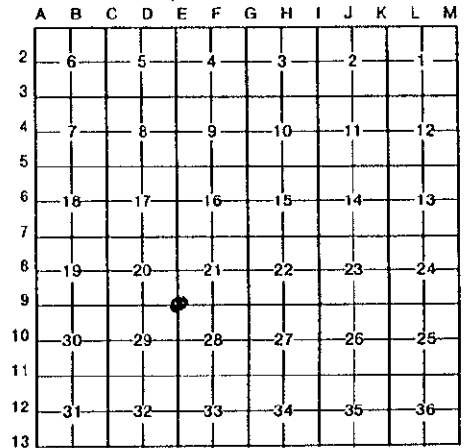

I, James H. Granger, in a field survey on August 4, 19 94, do hereby certify that under requirements of P.A. 74, Michigan P.A. of 1970, the corner points mentioned in lines 1 and 2 above were in conformance with regulations and rules therefore as required in the current manual of survey instructions of the United States Department of the Interior, Bureau of Land Management or by a decree of a Court of Law and/or that the corner points mentioned in lines 3, 4 and 5 above were in conformance with the rules of the Michigan Board of Land Surveyors or by a Decree of a Court of Law; established, re-established, monumented, re-monumented, recovered, found as expressed below:

**NOTE: Not more than 4 corners, all in the same town and range, may be recorded on this certificate.**

**A. Description of original monument and accessories and/or subsequent restoration:**

- 1845 original survey set wood post
- H. Brevoort 12" hemlock N70°E 26 lks.
- 10" hemlock S33°E 6 lks.
- 1960 DNR set 1/2" bar
- Billy Buckler #8887
- 1979 DNR set "T" iron
- Billy Buckler #8887

**B. Description of corner evidence found and/or method applied in restoring or reestablishing corner:**

found "T" iron and 4 witnesses


ACCEPTED BY THE MACKINAC COUNTY SURVEY PEER GROUP AS THE OFFICIAL CORNER UNDER P.A. 345 OF 1990 AT A MEETING HELD ON 8-16-94

*James H. Granger*

**C. Description of monument for corner and accessories established to perpetuate locating the position of the corner:**

set 5/8" rerod w/alum. cap

- 2" spruce S57°W 37.00' tag #31591
- 3" aspen N62°W 35.50' tag #31591
- 3" cedar S50°E 44.10' tag #31591
- 1 1/2" cedar N81°E 53.22' tag #31591

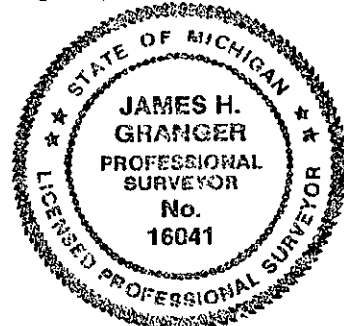

Signed by James H. Granger Date August 30, 1994  
 Surveyor's Michigan License No. 16041

09-06-94 16041

D-0236