

LAND CORNER RECORDATION CERTIFICATE
Filing Requirement of Act 74, Mich. P.A. 1970

For corners in

Mackinac

(County)

Located In:

Corner Code #

1. Public Land Survey	T	R	_____
	T	R	_____
	T	R	_____
	T	R	_____
2. Property Controlling in Section	S <u>32</u>	T <u>44N</u> R <u>8W</u>	<u>12</u>
	S <u>32</u>	T <u>44N</u> R <u>8W</u>	<u>15</u>
3. Miscellaneous Property in Sec.	S	T	_____
	S	T	_____

Register of Deeds Stamp & File Number

4. Lot No. _____, Recorded Plat _____
 5. Private Claims _____

Sep 28 2004

I, Stephan J. Szyszkoski, in a field survey on _____, 19____ do hereby state that under requirements of P.A. 74, Michigan P.A. of 1970, the corner points mentioned in lines 1 and 2 above were in conformance with regulations and rules therefore as required in the current manual of survey instructions of the United States Department of the Interior, Bureau of Land Management or by a decree of a Court of Law and /or that the corner points mentioned in lines 3, 4 and 5 above were in conformance with the rules of the Michigan Board of Land Surveyors or by a Decree of a Court of Law; established, re-established, monumented, recovered, found as expressed below:

NOTE: Not more than 2 corners, all in the same town and range, may be recorded on this certificate.

	A	B	C	D	E	F	G	H	I	J	K	L	M
1													
2		6		5		4		3		2		1	
3													
4		7		8		9		10		11		12	
5													
6		18		17		16		15		14		13	
7													
8		19		20		21		22		23		24	
9													
10		30		29		28		27		26		25	
11													
12		31		32		33		34		35		36	
13													

A. Description of original monument and accessories and/or subsequent restoration:
 (12-Sec. 32) South 1/16 corner, Section 32. Not established in the original survey.
 (15-Sec. 32) West 1/16 corner on the South line of Sec. 32. Not established in the original survey.


B. Description of corner evidence found and/or method applied in restoring or reestablishing corner:

(12-Sec. 32) Established the corner midway and on line between Center of Section (unmonumented) 1328.43' north and Quarter corner 1328.43' south. From the corner thus established, a N-S fence is East 5 feet, and a fence to the west is South, 95 feet.
 (15-Sec. 32) Established the corner on the Township line between Section corner 1323.51' West and Quarter corner 1323.51' East. The center of a road is 73' north of the corner monument.

C. Description of monument for corner and accessories established to perpetuate locating the position of the corner:

(12) Set 1"IDx36" I.pipe with 4" alum. MDNR cap. Set measuring nails with tags in:
 5" R.Pine N57E 24.95' mrkd "S1/16 BT"
 12" R.Pine S39E 24.4' do
 5" Cherry S18W 34.25' do
 6" Cherry N73W 13.15' do
 Bearings are magnetic. Distances are to nail with tag.

(15) Set 1"IDx36" I.pipe with plastic cap "MICH DNR PS33986". Set measuring nails with tags in:
 10" W.Birch S24W 37.0'
 8" Cherry N41E 111.25'
 Cor. fnc post (E-W-S) S15E 65.5'
 Cor. fnc post (W-N) N20E 109.0'
 North rail of RR is South 3.6'
 A 1" I.pipe with cap East 12.04' for the 1/16 Corner on the North Line of Sec. 5, T43N-R08W. Brgs are magnetic.

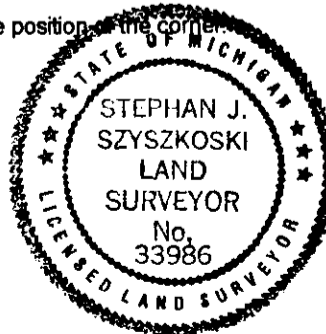

Signed by Stephan J. Szyszkoski

Surveyor's Michigan License No. 33986

Date 10/27/04