

LAND CORNER RECORDATION CERTIFICATE
Filing Requirement of Act 74, Mich. P.A. 1970

For corners in
Mackinac

(County)

Located In:

Corner Code #

1. Public Land Survey	T <u>44</u> N R <u>8</u> W	C11
	T <u>44</u> N R <u>8</u> W	E12
	T <u> </u> R <u> </u>	_____
	T <u> </u> R <u> </u>	_____
2. Property Controlling in Section	S <u> </u> T <u> </u> R <u> </u>	_____
	S <u> </u> T <u> </u> R <u> </u>	_____
3. Miscellaneous Property in Sec.	S <u> </u> T <u> </u> R <u> </u>	_____
	S <u> </u> T <u> </u> R <u> </u>	_____

Register of Deeds Stamp & File Number

4. Lot No. _____, Recorded Plat _____

5. Private Claims _____

Oct 19 2004

I, Stephan J. Szyszkoski, in a field survey on _____, 19____ do hereby state that under requirements of P.A. 74, Michigan P.A. of 1970, the corner points mentioned in lines 1 and 2 above were in conformance with regulations and rules therefore as required in the current manual of survey instructions of the United States Department of the Interior, Bureau of Land Management or by a decree of a Court of Law and /or that the corner points mentioned in lines 3, 4 and 5 above were in conformance with the rules of the Michigan Board of Land Surveyors or by a Decree of a Court of Law, established, re-established, monumented, recovered, found as expressed below:

NOTE: Not more than 2 corners, all in the same town and range, may be recorded on this certificate.

A	B	C	D	E	F	G	H	I	J	K	L	M
1												
2	6	5	4	3	2	1						
3												
4	7	8	9	10	11	12						
5												
6	10	17	16	15	14	13						
7												
8	19	20	21	22	23	24						
9												
10	30	29	28	27	26	25						
11		●										
12	31	32	●	33	34	35	36					
13												

A. Description of original monument and accessories and/or subsequent restoration:

(C11) Corner common to Sections 29-30-31-32. 1960 - Remonumented by Billy D. Buckler RLS in the original position from original 8T Cedar N60W 13 links (the bearing erroneously noted as N60E in the 1960 record). Set 1" pipe with 4" brass cap. 10" Cedar N47E 35 links, 10" Cedar S01E 26 links.

(E12) Quarter corner common to Sections 32-33. 1961 - Reestablished by Billy D. Buckler RLS midway and on line between Section corners. 3/8"x24" iron bar set. 7" J.Pine S88E 73.5 links, 7" J.Pine N54E 91 links. 1974 - Lawrence Feindt RLS recovered the 1961 monument and placed 1" ID iron pipe over it. 8" J.Pine S88E 48.60', 8" Pine S33E 62.40', 5" Pine N75W 74.80'.

B. Description of corner evidence found and/or method applied in restoring or reestablishing corner:


(C11) Recovered the 1960 monument in good condition and at record bearing and distance from the 1960 NBTs, the Cedar NE now dead and down, the Cedar SE now standing dead. The monument was also recovered at record bearing and distance from the original 8T Cedar N60W, still green and in good condition, with measuring notch visible.

(E12) The previous monuments of record were not recovered. Reestablished the corner at record bearing and distance from the 1961 and 1974 NBTs, four of which were found in good condition and redescribed below. At the position thus reestablished, drove a 5/8" dia. x 24" rebar with a plastic cap. The corner falls on the centerline of asphalt-paved Borgstrom Rd.

C. Description of monument for corner and accessories established to perpetuate locating the position of the corner:

(C11) Found 1" ID I. pipe with 4" brass MI Dept. of Conservation cap. Set measuring nails with tags in:
 20" Cedar N50W 8.65' old blazes *
 6" Maple S62E 12.65' blazed no scribing
 9" Cedar S14E 35.75' do
 10" Y. Birch S23W 9.5' do
 Bearings are magnetic. Distances are to nail with tag. * denotes 1845 OBT.

(E12) Set 5/8"x24" rebar with plastic cap "MICH DNR PS33986" in Borgstrom Rd. Set measuring nails with tags in the previous witnesses of record:
 12" J.Pine N69W 74.8' wrkd "1/4S NBT"
 14" R.Pine N57E 60.7' "1/4S"
 10" J.Pine S85E 48.85' do
 12" J.Pine S37E 61.85' "1/4S NBT"
 Bearings are magnetic. Distances are to nail with tag.

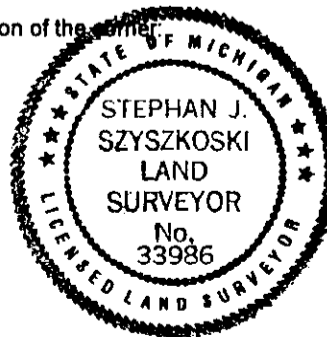

Signed by Stephan J. Szyszkoski
 Surveyor's Michigan License No. 33986

Date 10/27/04