

**LAND CORNER RECORDATION CERTIFICATE**  
**Filing Requirement of Act 74, Mich. P.A. 1970**

For corners in

Mackinac  
 (County)

Located In:

Corner Code #

1. Public Land Survey	T <u>44N</u> R <u>9W</u>	<u>K12</u>
	T <u>    </u> R <u>    </u>	<u>    </u>
	T <u>    </u> R <u>    </u>	<u>    </u>
	T <u>    </u> R <u>    </u>	<u>    </u>
2. Property Controlling in Section	S <u>36</u> T <u>44N</u> R <u>9W</u>	<u>3</u>
	S <u>    </u> T <u>    </u> R <u>    </u>	<u>    </u>
3. Miscellaneous Property in Sec.	S <u>    </u> T <u>    </u> R <u>    </u>	<u>    </u>
	S <u>    </u> T <u>    </u> R <u>    </u>	<u>    </u>

Register of Deeds Stamp & File Number

4. Lot No. \_\_\_\_\_, Recorded Plat \_\_\_\_\_  
 5. Private Claims \_\_\_\_\_

Jan 24 2007

I, Stephan J. Szyszkoski, in a field survey on \_\_\_\_\_, 19\_\_\_\_ do hereby state that under requirements of P.A. 74, Michigan P.A. of 1970, the corner points mentioned in lines 1 and 2 above were in conformance with regulations and rules therefore as required in the current manual of survey instructions of the United States Department of the Interior, Bureau of Land Management or by a decree of a Court of Law and /or that the corner points mentioned in lines 3, 4 and 5 above were in conformance with the rules of the Michigan Board of Land Surveyors or by a Decree of a Court of Law; established, re-established, monumented, recovered, found as expressed below:

**NOTE: Not more than 2 corners, all in the same town and range, may be recorded on this certificate.**

	A	B	C	D	E	F	G	H	I	J	K	L	M
1													
2		6		5		4		3		2		1	
3													
4		7		8		9		10		11		12	
5													
6		18		17		16		15		14		13	
7													
8		19		20		21		22		23		24	
9													
10		30		29		28		27		26		25	
11													
12		31		32		33		34		35		36	
13													

**A. Description of original monument and accessories and/or subsequent restoration:**


(K12) Quarter corner common to Sections 35 and 36. 1849 - Established by Wm. Ives, Deputy Surveyor, midway and on line between Section corners 40.00 chains north and south. Set post. W.Pine 6 S28E 14 links, Aspen 6 N37W 35 links. Found no subsequent record.  
 (3-Sec. 36) North 1/16 corner between Sections 35 and 36. Not established in the original survey.

**B. Description of corner evidence found and/or method applied in restoring or reestablishing corner:**

(K12) The original post and accessories were not recovered. Found no evidence of the position of the original corner on the ground. Reestablished the corner midway and on the Section line between Section corners 2667.07' north and south.  
 (3-Sec. 36) Established the corner midway and on the Section line between Quarter corner 1333.53' south and Section corner 1333.53' north.

**C. Description of monument for corner and accessories established to perpetuate locating the position of the corner:**

(K12) Set 1"IDx36" I.pipe with 4" alum. MDNR cap. Set measuring nails in: 5" Maple S47E 3.16' mrkd "1/4S NBT" 4" W.Pine S22W 9.07' do 5" Maple S88W 12.77' do 7" Spruce N04W 28.8' do Bearings are magnetic. Distances are to nail with tag.	(3) Set 1"IDx36" I.pipe with 4" alum. MDNR cap. Set measuring nails in: 6" W.Pine N77E 4.96' mrkd "N1/16 BT" 6" W.Pine S14E 13.3' do 13" R.Pine S51W 17.12' do 7" W.Pine N80W 11.7' do Bearings are magnetic. Distances are to nail with tag.
---	---

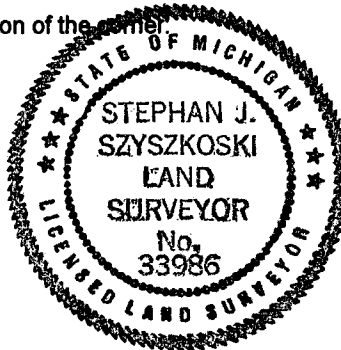

Signed by Stephan J. Szyszkoski  
 Surveyor's Michigan License No. 33986

Date 5/16/07

For the Michigan Department of Natural Resources