

**LAND CORNER RECORDATION CERTIFICATE**  
**Filing Requirement of Act 74, Mich. P.A. 1970**

For corners in

Mackinac

(County)

Located In:

Corner Code #

1. Public Land Survey	T <u>44</u> N	R <u>9</u> W	<u>L11</u>
	T _____	R _____	_____
	T _____	R _____	_____
	T _____	R _____	_____
2. Property Controlling in Section	S <u>36</u>	T <u>44</u> N	R <u>9</u> W
	S _____	T _____	R _____
3. Miscellaneous Property in Sec.	S _____	T _____	R _____
	S _____	T _____	R _____

Register of Deeds Stamp & File Number

4. Lot No. \_\_\_\_\_, Recorded Plat \_\_\_\_\_  
 5. Private Claims \_\_\_\_\_

Jan 29 2007

I, Stephan J. Szyszkoski, in a field survey on \_\_\_\_\_, 19\_\_\_\_ do hereby state that under requirements of P.A. 74, Michigan P.A. of 1970, the corner points mentioned in lines 1 and 2 above were in conformance with regulations and rules therefore as required in the current manual of survey instructions of the United States Department of the Interior, Bureau of Land Management or by a decree of a Court of Law and /or that the corner points mentioned in lines 3, 4 and 5 above were in conformance with the rules of the Michigan Board of Land Surveyors or by a Decree of a Court of Law; established, re-established, monumented, recovered, found as expressed below:

NOTE: Not more than 2 corners, all in the same town and range, may be recorded on this certificate.

A	B	C	D	E	F	G	H	I	J	K	L	M
1												
2	6		5		4		3		2		1	
3												
4	7		8		9		10		11		12	
5												
6	18		17		16		15		14		13	
7												
8	19		20		21		22		23		24	
9												
10	30		29		28		27		26		25	
11												
12	31		32		33		34		35		36	
13												

A. Description of original monument and accessories and/or subsequent restoration:


(L11) Quarter corner common to Sections 25 and 36. 1849 - Established by Wm. Ives, Deputy Surveyor, midway and on the Section line between Section corners 39.86 chains east and west. Set post. Spruce 6 S34W 13 links, Fir 5 N22E 06 links. Found no subsequent record.  
 (5-Sec. 36) North 1/16 corner, Section 36. Not established in the original survey.

B. Description of corner evidence found and/or method applied in restoring or reestablishing corner:

(L11) The original post and accessories were not recovered. Found no evidence of the position of the original corner on the ground. Reestablished the corner midway and on the Section line between Section corners 2603.44' east and west.  
 (5-Sec. 36) Established the corner midway and on a straight line between Quarter corner L11 1327.03' north and Center of Section 36 1327.03' south.

C. Description of monument for corner and accessories established to perpetuate locating the position of the corner:

(L11) Set 1"IDx36" I.pipe with 4" alum. MDNR cap. Set measuring nails in: 8" Spruce N15W 6.97' mrkd "1/4S NBT" 5" Balsam N76E 7.5' do 5" Balsam S16W 8.28' do 5" Balsam S65W 12.7' do Bearings are magnetic. Distances are to nail with tag.	(5) Set 1"IDx36" I.pipe with 4" alum. MDNR cap. Set measuring nails in: 10" W.Pine N87E 25.65' mrkd "N1/16 BT" 12" W.Pine S51W 28.78' do 5" Spruce S03E 43.68' do 22" W.Pine N48E 84.62' do Bearings are magnetic. Distances are to nail with tag.
---	---

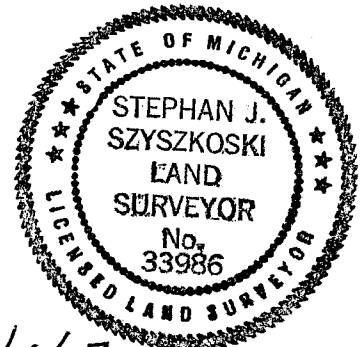

Signed by Stephan J. Szyszkoski  
 Surveyor's Michigan License No. 33986

Date 5/16/07

For the Michigan Department of Natural Resources