

LAND CORNER RECORDATION CERTIFICATE
Filing Requirement of Act 74, Mich. P.A. 1970

For corners in

Mackinac

(County)

Located In:

Corner Code #

1. Public Land Survey

T44N R 9W M12
 T R
 T R
 T R

2. Property Controlling in Section

S36 T44N R 9W 13
 S T R
 S T R

3. Miscellaneous Property in Sec.

S T R
 S T R

Register of Deeds Stamp & File Number

4. Lot No. _____, Recorded Plat _____

5. Private Claims _____

M12 Jan 29 2007
 13 Jan 24 2007

I, Stephan J. Szyszkoski, in a field survey on _____, 19____ do hereby state that under requirements of P.A. 74, Michigan P.A. of 1970, the corner points mentioned in lines 1 and 2 above were in conformance with regulations and rules therefore as required in the current manual of survey instructions of the United States Department of the Interior, Bureau of Land Management or by a decree of a Court of Law and /or that the corner points mentioned in lines 3, 4 and 5 above were in conformance with the rules of the Michigan Board of Land Surveyors or by a Decree of a Court of Law; established, re-established, monumented, recovered, found as expressed below:

NOTE: Not more than 2 corners, all in the same town and range, may be recorded on this certificate.

A	B	C	D	E	F	G	H	I	J	K	L	M
1												
2	6	5	4	3	2	1						
3												
4	7	8	9	10	11	12						
5												
6	18	17	16	15	14	13						
7												
8	19	20	21	22	23	24						
9												
10	30	29	28	27	26	25						
11												
12	31	32	33	34	35	36						
13												

A. Description of original monument and accessories and/or subsequent restoration:


(M12) Quarter corner common to Section 36 T44N-R09W and Section 31 T44N-R08W. 1986 - Reestablished by G.L.Wiggins RLS midway and on line between NE and SE corners of Section 36. Set 1"ID I.pipe with 4" alum. MDNR cap. 8" W.Pine N50E 35.2', 8" W.Pine S73E 9.25', 6" W.Pine S15W 15.5', 4" W.Birch N12E 17.1'
 (13-Sec. 36) Southeast 1/16 corner, Section 36. Not established in the original survey.

B. Description of corner evidence found and/or method applied in restoring or reestablishing corner:

(M12) Recovered the 1986 monument in good condition and at record bearing and distance from the 1986 witnesses. The NBTs S73E and S15W were misnamed on the 1986 record. They are W. Birches, not W.Pines. Furthermore, the NBT S15W is now a stump. The remaining NBTs are in good condition. Verified the position of the monument, it being 0.65' SW of the position intended in 1986. I accept the monument as a careful and faithful reestablishment of the position of the original corner.
 (13-Sec. 36) Established the corner at the intersection of straight lines connecting opposite 1/16 corners. From the position thus established, I found a metal fence post by others, projecting 7', bearing S87W 67.8' distant.

C. Description of monument for corner and accessories established to perpetuate locating the position of the corner:

(M12) Found 1" I.pipe with 4" alum. MDNR cap. Set measuring nails in: 12" W.Pine N50E 35.7' mrkd "1/4S" * 9" W.Birch S72E 9.6' * 5" W.Birch N13E 17.3' * 5" Spruce S36W 12.55' mrkd "1/4S NBT" Fd. iron pipe in conc. S24W 112.22' Bearings are magnetic. Distances are to nail with tag. * denotes 1986 NBT.	(13) Set 1"IDx36" I.pipe with 4" alum. MDNR cap. Set measuring nails in: 8" Spruce S36W 5.06' mrkd "SE1/16 BT" 17" W.Pine N56W 20.95' do 13" W.Pine N85E 31.03' do 8" W.Pine S45E 21.93' do Bearings are magnetic. Distances are to nail with tag.
---	---

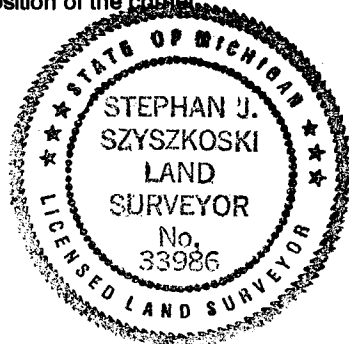

Signed by Stephan J. Szyszkoski
 Surveyor's Michigan License No. 33986

Date 5/16/07